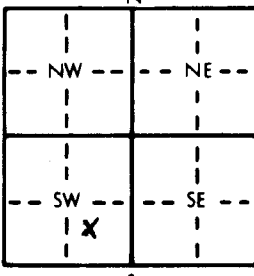
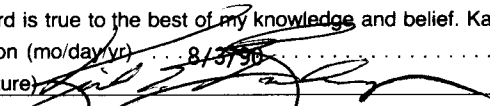


1 LOCATION OF WATER WELL:		Fraction		Section Number		Township Number		Range Number			
County: Harvey		SE 1/4 SW 1/4 1/4		9		T 22 S		R 1 E/W			
Distance and direction from nearest town or city street address of well if located within city?											
420 W. Lincoln Blvd., Hesston, Kansas											
2 WATER WELL OWNER: Hay & Forage Ind.											
RR#, St. Address, Box # : 420 W. Lincoln Blvd. Board of Agriculture, Division of Water Resources											
City, State, ZIP Code : Hesston, Kansas 67002 40/4004.01 Application Number:											
3 LOCATE WELL'S LOCATION WITH AN "X" IN SECTION BOX:											
<div style="text-align: center;">N 1 Mile W E S</div> 		4 DEPTH OF COMPLETED WELL: 16 ft. ELEVATION: N/A									
		Depth(s) Groundwater Encountered 1. ft. 2. ft. 3. ft.									
		WELL'S STATIC WATER LEVEL 9.14 ft. below land surface measured on mo/day/yr 8/9/90									
		Pump test data: Well water was ft. after hours pumping gpm									
Est. Yield gpm: Well water was ft. after hours pumping gpm											
Bore Hole Diameter 6.5 in. to 16 ft., and in. to ft.											
WELL WATER TO BE USED AS: 5 Public water supply 8 Air conditioning 11 Injection well											
1 Domestic 3 Feedlot 6 Oil field water supply 9 Dewatering 12 Other (Specify below)											
2 Irrigation 4 Industrial 7 Lawn and garden only 10 Monitoring well C-8											
Was a chemical/bacteriological sample submitted to Department? Yes No <input checked="" type="checkbox"/> If yes, mo/day/yr sample was submitted											
Water Well Disinfected? Yes No <input checked="" type="checkbox"/>											
5 TYPE OF BLANK CASING USED:											
1 Steel 3 RMP (SR) 5 Wrought iron 8 Concrete tile CASING JOINTS: Glued Clamped											
2 PVC 4 ABS 6 Asbestos-Cement 9 Other (specify below) Welded											
Blank casing diameter 2 in. to 16 ft., Dia in. to ft., Dia in. to ft.											
Casing height above land surface flush in., weight lbs./ft. Wall thickness or gauge No. Sch. 40											
TYPE OF SCREEN OR PERFORATION MATERIAL:											
1 Steel 3 Stainless steel 5 Fiberglass 8 RMP (SR) 10 Asbestos-cement											
2 Brass 4 Galvanized steel 6 Concrete tile 9 ABS 11 Other (specify)											
12 None used (open hole)											
SCREEN OR PERFORATION OPENINGS ARE:											
1 Continuous slot 2 Mill slot 5 Gauzed wrapped 8 Saw cut 11 None (open hole)											
2 Louvered shutter 4 Key punched 7 Torch cut 9 Drilled holes											
10 Other (specify)											
SCREEN-PERFORATED INTERVALS: From 6 ft. to 16 ft., From ft. to ft.											
From ft. to ft., From ft. to ft.											
GRAVEL PACK INTERVALS: From 5 ft. to 16 ft., From ft. to ft.											
From ft. to ft., From ft. to ft.											
6 GROUT MATERIAL: 1 Neat cement 2 Cement grout 3 Bentonite 4 Other Volclay Grout											
Grout Intervals: From 1 ft. to 4 ft., From ft. to ft.											
What is the nearest source of possible contamination:											
1 Septic tank 4 Lateral lines 7 Pit privy 10 Livestock pens 14 Abandoned water well											
2 Sewer lines 5 Cess pool 8 Sewage lagoon 11 Fuel storage 15 Oil well/Gas well											
3 Watertight sewer lines 6 Seepage pit 9 Feedyard 12 Fertilizer storage 16 Other (specify below)											
13 Insecticide storage											
Direction from well? NE How many feet?											
FROM		TO		LITHOLOGIC LOG		FROM		TO		PLUGGING INTERVALS	
0		6"		Concrete		13		14		Clay as above calcareous	
6"		1'		Fill sand		14		16		Sandy clay (weathered shale), light brown mottled reddish brown, <20% medium sand	
1'		4'		Clay dark brown mottled reddish brown, <20% very fine sand, stiff, medium to high plasticity							
4'		7'		Clay as above dark gray, no mottling							
7'		11'		Clay brown to tan, <20% very fine sand calcareous @ 8'							
11'		13'		Sandy clay, light brown to tan, <20% fine sand, high plasticity							
7 CONTRACTOR'S OR LANDOWNER'S CERTIFICATION: This water well was (X) constructed, (2) reconstructed, or (3) plugged under my jurisdiction and was completed on (mo/day/year) 8/2/90 and this record is true to the best of my knowledge and belief. Kansas Water Well Contractor's License No. 471 This Water Well Record was completed on (mo/day/yr) 8/3/90 under the business name of HWS Technologies Inc. by (signature) 											
INSTRUCTIONS: Use typewriter or ball point pen. PLEASE PRESS FIRMLY and PRINT clearly. Please fill in blanks, underline or circle the correct answers. Send top three copies to Kansas Department of Health and Environment, Bureau of Water, Topeka, Kansas 66620-7320. Telephone: 913-296-5545. Send one to WATER WELL OWNER and retain one for your records.											