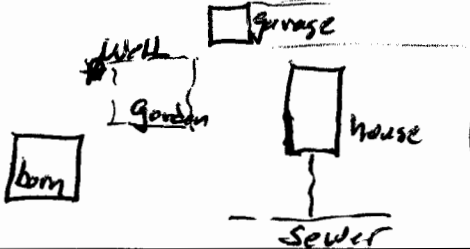


USE TYPEWRITER OR BALL
POINT PEN-PRESS FIRMLY,
PRINT CLEARLY.

WATER WELL RECORD
KSA 82a-1201-1215

Kansas Department of Health and
Environment-Division of Environment
(Water well Contractors)
Topeka, Kansas 66620

1. Location of well:		County HARVEY	Fraction NW 1/4 SE 1/4 NE 1/4	Section number 14	Township number T 22 S R 1 E W	Range number
2. Distance and direction from nearest town or city: Street address of well location if in city:		1 1/2 EAST of HESSON		3. Owner of well: R.R. or street: City, state, zip code:		
				Keith Ellis RR #1 Hesson, KS 67062		
4. Locate with "X" in section below: N W E S 1 Mile		Sketch map: 		6. Bore hole dia. 4 1/2 in. Completion date Well depth 48 ft. 8/22/78		
5. Type and color of material		From	To	7. <input type="checkbox"/> Cable tool <input checked="" type="checkbox"/> Rotary <input type="checkbox"/> Driven <input type="checkbox"/> Dug <input type="checkbox"/> Hollow rod <input type="checkbox"/> Jetted <input type="checkbox"/> Bored <input type="checkbox"/> Reverse rotary		
LOAM to BROWN CLAY		0	5	8. Use: <input type="checkbox"/> Domestic <input type="checkbox"/> Public supply <input type="checkbox"/> Industry <input checked="" type="checkbox"/> Irrigation <input type="checkbox"/> Air conditioning <input type="checkbox"/> Stock <input checked="" type="checkbox"/> Lawn <input type="checkbox"/> Oil field water <input type="checkbox"/> Other		
SANDY BROWN CLAY		5	10	9. Casing: Material plastic Height Above or below Threaded <input type="checkbox"/> Welded <input type="checkbox"/> Surface 24 in. RMP <input type="checkbox"/> PVC <input checked="" type="checkbox"/> Weight 3.62 lbs./ft. Dia. 6 in. to 48 ft. depth Wall Thickness: inches or Dia. <input type="checkbox"/> in. to <input type="checkbox"/> ft. depth gauge No. 280		
SAND - MED		12	16	10. Screen: Manufacturer's name Kem-Tech Type PVC Dia. 6 1/4 Slot/gauze 1020 Length 10' Set between 45 ft. and 35' ft. ft. and <input type="checkbox"/> ft. Gravel pack? <input checked="" type="checkbox"/> Size range of material 1/8-1/4		
White/GREY - gritty clay		16	20	11. Static water level: <input type="checkbox"/> mo./day/yr. 22' ft. below land surface Date 8/22/78		
BROWN RED CLAY - fine SAND		20	30	12. Pumping level below land surfaces: 31 1/2 ft. after 2 hrs. pumping 18 g.p.m. <input type="checkbox"/> ft. after <input type="checkbox"/> hrs. pumping <input type="checkbox"/> g.p.m. Estimated maximum yield 20/30 g.p.m.		
SAND - fine redish		30	34	13. Water sample submitted: <input type="checkbox"/> Yes <input checked="" type="checkbox"/> No Date <input type="checkbox"/> mo./day/yr.		
CLAY - soft grey		34	35	14. Well head completion: <input type="checkbox"/> Pitless adapter 24 Inches above grade		
SAND - compacted eguas		35	40	15. Well grouted? <input checked="" type="checkbox"/> With: <input checked="" type="checkbox"/> Neat cement <input type="checkbox"/> Bentonite <input type="checkbox"/> Concrete Depth: From 10 ft. to 0 ft.		
SHALE - green		40	42	16. Nearest source of possible contamination: house ft. 80 Direction SE Type sewer Well disinfected upon completion? <input type="checkbox"/> Yes <input checked="" type="checkbox"/> No		
GRAVEL		42	45	17. Pump: <input checked="" type="checkbox"/> Not installed Manufacturer's name <input type="checkbox"/> Model number <input type="checkbox"/> HP <input type="checkbox"/> Volts <input type="checkbox"/> Length of drop pipe <input type="checkbox"/> ft. capacity <input type="checkbox"/> g.p.m. Type: <input type="checkbox"/> Submersible <input type="checkbox"/> Turbine <input type="checkbox"/> Jet <input type="checkbox"/> Reciprocating <input type="checkbox"/> Centrifugal <input type="checkbox"/> Other		
SHALE - green-grey		45	46	20. Water well contractor's certification: This well was drilled under my jurisdiction and this report is true to the best of my knowledge and belief. PAUL'S INC #125 Business name Hesson, KS License No. Address Paul Brundant Date 9/14/78 Signed Paul Brundant Authorized representative		
SHALE - grey		46	48			
18. Elevation:		19. Remarks:				
Topography: <input type="checkbox"/> Hill <input type="checkbox"/> Slope <input type="checkbox"/> Upland <input type="checkbox"/> Valley						

Forward the white, blue and pink copies to the Department of Health and Environment

Form WWC-5