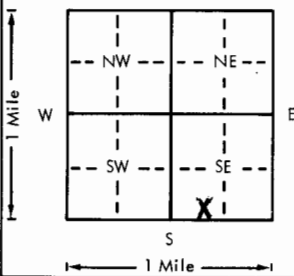
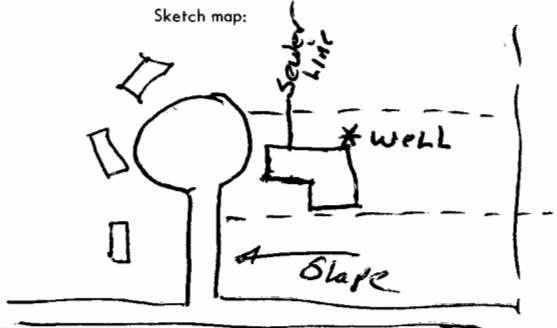


USE TYPEWRITER OR BALL
POINT PEN-PRESS FIRMLY,
PRINT CLEARLY.

WATER WELL RECORD
KSA 82a-1201-1215

Kansas Department of Health and
Environment-Division of Environment
(Water well Contractors)
Topeka, Kansas 66620

1. Location of well:		County HARVEY	Fraction SE 1/4 SW 1/4 SE 1/4	Section number 15	Township number T 22 S R 1 E	Range number 1
2. Distance and direction from nearest town or city: Street address of well location if in city:			3. Owner of well: Lowell Roth R.R. or street: City, state, zip code: Hesston, KS 67062			
4. Locate with "X" in section below:		Sketch map:		6. Bore hole dia. 12 in. Completion date 5/5/77 Well depth 48 ft.		
				7. <input checked="" type="checkbox"/> Cable tool <input checked="" type="checkbox"/> Rotary <input type="checkbox"/> Driven <input type="checkbox"/> Dug <input type="checkbox"/> Hollow rod <input type="checkbox"/> Jetted <input type="checkbox"/> Bored <input type="checkbox"/> Reverse rotary		
5. Type and color of material		From	To	8. Use: <input type="checkbox"/> Domestic <input type="checkbox"/> Public supply <input type="checkbox"/> Industry <input checked="" type="checkbox"/> Irrigation <input type="checkbox"/> Air conditioning <input type="checkbox"/> Stock <input checked="" type="checkbox"/> Lawn <input type="checkbox"/> Oil field water <input type="checkbox"/> Other		
Loam to red clay		0	5	9. Casing: Material plastic Height: Above or below Threaded <input type="checkbox"/> Welded <input checked="" type="checkbox"/> Surface 18 in. RMP <input type="checkbox"/> PVC <input checked="" type="checkbox"/> Weight 3.23 lbs./ft. Dia. 6 in. to 48 ft. depth Wall Thickness: inches or Dia. <input type="checkbox"/> in. to <input type="checkbox"/> ft. depth gage No. 1228		
Red clay		5	10	10. Screen: Manufacturer's name Robin-Tech - own slot Type pvc Dia. 6" Slot/gauze .046 Length 10' Set between 25 ft. and 35 ft. Set between <input type="checkbox"/> ft. and <input type="checkbox"/> ft.		
" " SANDY		10	14	Gravel pack? <input checked="" type="checkbox"/> Size range of material 1/8-1/4		
SAND med coarse - brown		14	21	11. Static water level: <input type="checkbox"/> mo./day/yr. 16 ft. below land surface Date 5/5/77		
SANDY GRAY CLAY		21	26	12. Pumping level below land surfaces: 21 ft. after 1 hrs. pumping 18 g.p.m. <input type="checkbox"/> ft. after <input type="checkbox"/> hrs. pumping <input type="checkbox"/> g.p.m. Estimated maximum yield 35 g.p.m.		
SAND MED - clear white -		26	34	13. Water sample submitted: <input type="checkbox"/> mo./day/yr. Yes <input checked="" type="checkbox"/> No Date		
SAND to red green shale		34	35	14. Well head completion: <input type="checkbox"/> Pitless adapter 18 inches above grade		
Green grey to dark shale		35	37	15. Well grouted? <input checked="" type="checkbox"/> With: <input checked="" type="checkbox"/> Neat cement <input type="checkbox"/> Bentonite <input type="checkbox"/> Concrete Depth: From 10 ft. to 0 ft.		
dark gray shale		37	48	16. Nearest source of possible contamination: house ft. 43' Direction West Type Sewer Well disinfected upon completion? <input type="checkbox"/> Yes <input checked="" type="checkbox"/> No		
(Use a second sheet if needed)				17. Pump: <input type="checkbox"/> Not installed Manufacturer's name WALLEY Model number S-1807-MG-3052 Volts 220 Length of drop pipe 40 ft. capacity 18 g.p.m. Type: <input checked="" type="checkbox"/> Submersible <input type="checkbox"/> Turbine <input type="checkbox"/> Jet <input type="checkbox"/> Reciprocating <input type="checkbox"/> Centrifugal <input type="checkbox"/> Other		
18. Elevation:	19. Remarks:		20. Water well contractor's certification: This well was drilled under my jurisdiction and this report is true to the best of my knowledge and belief. PAUL'S INC License No. 175 Business name Box 26 Hesston, KS Address Paul Beulley Date 5/31/77 Signed Paul Beulley Authorized representative			

2-2-10-15 SE SW SE
1/4 1/4 1/4

Forward the white, blue and pink copies to the Department of Health and Environment

Form WWC-5