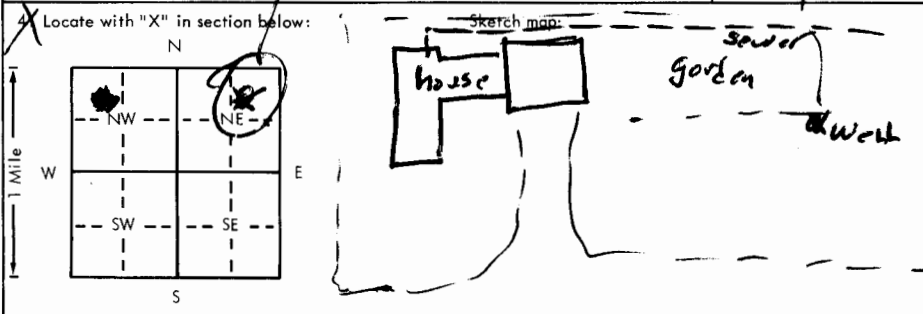


USE TYPEWRITER OR BALL
POINT PEN-PRESS FIRMLY,
PRINT CLEARLY.

WATER WELL RECORD
KSA 82a-1201-1215

Kansas Department of Health and
Environment-Division of Environment
(Water well Contractors)
Topeka, Kansas 66620

1. Location of well: County HARVEY Fraction NE 1/4 NE 1/4 Section number 16 Township number T 22 S Range number R 1 E	
2. Distance and direction from nearest town or city: Street address of well location if in city: SAME	
3. Owner of well: John Zielke R.R. or street: 500 N Weaver City, state, zip code: Hessston, Kansas 67062	
4. Locate with "X" in section below: 	
5. Type and color of material	
6. Bore hole dia. 12 in. Completion date 4-10-79 Well depth 45 ft.	
7. Cable tool <input checked="" type="checkbox"/> Rotary <input type="checkbox"/> Driven <input type="checkbox"/> Dug <input type="checkbox"/> Hollow rod <input type="checkbox"/> Jetted <input type="checkbox"/> Bored <input type="checkbox"/> Reverse rotary	
8. Use: <input type="checkbox"/> Domestic <input type="checkbox"/> Public supply <input type="checkbox"/> Industry <input checked="" type="checkbox"/> Irrigation <input type="checkbox"/> Air conditioning <input type="checkbox"/> Stock <input checked="" type="checkbox"/> Lawn <input type="checkbox"/> Oil field water <input type="checkbox"/> Other	
9. Casing: Material PLASTIC Height: Above or below Threaded <input type="checkbox"/> Welded <input checked="" type="checkbox"/> Surface 12 in. RMP <input type="checkbox"/> PVC <input checked="" type="checkbox"/> Weight 3.56 lbs./ft. Dia. 6 in. to 45 ft. depth Wall Thickness: inches or Dia. <input type="checkbox"/> in. to <input type="checkbox"/> ft. depth Gauge No. 1280	
10. Screen: Manufacturer's name Pumpco Type PVC Dia. 6" Slot/gauze 120 Length 2' Set between 30 ft. and 37 ft. 30 ft. and 37 ft. Gravel pack? <input checked="" type="checkbox"/> Size range of material 16-14	
11. Static water level: 15 ft. below land surface Date 4/10/79	
12. Pumping level below land surfaces: 40 ft. after 2 hrs. pumping 10 g.p.m. 40 ft. after 2 hrs. pumping 10 g.p.m. Estimated maximum yield 10 g.p.m.	
13. Water sample submitted: Yes <input checked="" type="checkbox"/> No <input type="checkbox"/> Date 4/10/79	
14. Well head completion: <input type="checkbox"/> Pitless adapter 12 inches above grade	
15. Well grouted? <input checked="" type="checkbox"/> With: <input checked="" type="checkbox"/> Neat cement <input type="checkbox"/> Bentonite <input type="checkbox"/> Concrete Depth: From 10 ft. to 0 ft.	
16. Nearest source of possible contamination: house ft. 25 Direction N Type sewer Well disinfected upon completion? Yes <input checked="" type="checkbox"/> No <input type="checkbox"/>	
17. Pump: <input type="checkbox"/> Not installed Manufacturer's name Dempster Model number MBL-2-5A 43 Volts 115 Length of drop pipe 40 ft. capacity 12 g.p.m. Type: <input checked="" type="checkbox"/> Submersible <input type="checkbox"/> Turbine <input type="checkbox"/> Jet <input type="checkbox"/> Reciprocating <input type="checkbox"/> Centrifugal <input type="checkbox"/> Other	
20. Water well contractor's certification: This well was drilled under my jurisdiction and this report is true to the best of my knowledge and belief. PAUL'S INC #175 Business name Box 26 Hessston License No. Address Paul B. Bland Date 4/21/79 Signed Paul B. Bland Authorized representative	
18. Elevation: Topography: <input type="checkbox"/> Hill <input type="checkbox"/> Slope <input type="checkbox"/> Upland <input type="checkbox"/> Valley	19. Remarks: (Use a second sheet if needed)