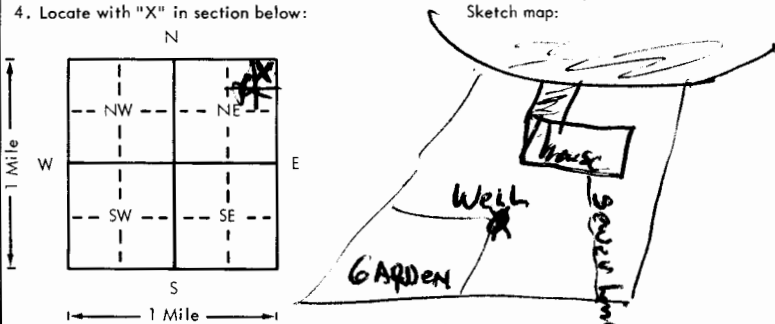


USE TYPEWRITER OR BALL  
POINT PEN-PRESS FIRMLY,  
PRINT CLEARLY.

WATER WELL RECORD  
KSA 82a-1201-1215

Kansas Department of Health and  
Environment-Division of Environment  
(Water well Contractors)  
Topeka, Kansas 66620

1. Location of well:	County <b>HARVEY</b>	Fraction <b>NE 1/4 NE 1/4 NE 1/4</b>	Section number <b>16</b>	Township number <b>T 22 S</b>	Range number <b>R 1</b>
2. Distance and direction from nearest town or city: Street address of well location if in city:	<b>SAME</b>		3. Owner of well: <b>Richard Wiens</b> R.R. or street: <b>#4 SUNRISE COURT</b> City, state, zip code: <b>HESSLEY, KS. - 67062</b>		
4. Locate with "X" in section below: 	6. Bore hole dia. <b>12</b> in. Completion date <b>5-7-79</b> Well depth <b>42</b> ft. 7. <input checked="" type="checkbox"/> Cable tool <input checked="" type="checkbox"/> Rotary <input type="checkbox"/> Driven <input type="checkbox"/> Dug <input type="checkbox"/> Hollow rod <input type="checkbox"/> Jetted <input type="checkbox"/> Bored <input type="checkbox"/> Reverse rotary 8. Use: <input type="checkbox"/> Domestic <input type="checkbox"/> Public supply <input type="checkbox"/> Industry <input checked="" type="checkbox"/> Irrigation <input type="checkbox"/> Air conditioning <input type="checkbox"/> Stock <input checked="" type="checkbox"/> Lawn <input type="checkbox"/> Oil field water <input type="checkbox"/> Other 9. Casing: Material <b>Plastic</b> Height Above or below Threaded <input type="checkbox"/> Welded <input checked="" type="checkbox"/> Surface <b>12</b> in. RMP <input type="checkbox"/> PVC <input checked="" type="checkbox"/> Weight <b>3.58</b> lbs./ft. Dia. <b>6</b> in. to <b>42</b> ft. depth Wall Thickness: inches or Dia. <input type="checkbox"/> in. to <input type="checkbox"/> ft. depth gage No. <b>280</b>				
5. Type and color of material	From	To	10. Screen: Manufacturer's name <b>Pumpco</b> Type <b>PL</b> Dia. <b>6"</b> Slot/gauze <b>020</b> Length <b>10</b> Set between <input type="checkbox"/> ft. and <input type="checkbox"/> ft. <b>27'</b> ft. and <b>37'</b> ft. Gravel pack? <input checked="" type="checkbox"/> Size range of material <b>1/8-1/4</b>		
<b>LOAM TO CLAY</b>	<b>0</b>	<b>2</b>	11. Static water level: <input type="checkbox"/> mo./day/yr. <b>14 1/2</b> ft. below land surface Date <b>5-7-79</b>		
<b>GREY CLAY</b>	<b>2</b>	<b>7</b>	12. Pumping level below land surfaces: ft. after <input type="checkbox"/> hrs. pumping <input type="checkbox"/> g.p.m. <b>22 1/2</b> ft. after <b>2</b> hrs. pumping <b>20</b> g.p.m. Estimated maximum yield <b>30</b> g.p.m.		
<b>RED BROWN CLAY</b>	<b>7</b>	<b>12</b>	13. Water sample submitted: <input type="checkbox"/> mo./day/yr. <input type="checkbox"/> Yes <input checked="" type="checkbox"/> No Date		
<b>TAN CLAY /w ALKALI</b>	<b>12</b>	<b>25</b>	14. Well head completion: <input type="checkbox"/> Pitless adapter <b>12</b> Inches above grade		
<b>SAND - MED to COARSE</b>	<b>25</b>	<b>36</b>	15. Well grouted? <input checked="" type="checkbox"/> With: <input checked="" type="checkbox"/> Neat cement <input type="checkbox"/> Bentonite <input type="checkbox"/> Concrete Depth: From <b>0</b> ft. to <b>10</b> ft.		
<b>GREEN - RED SHALE</b>	<b>36</b>	<b>42</b>	16. Nearest source of possible contamination: <b>house</b> ft. <b>35</b> Direction <b>SO</b> Type <b>sewer</b> Well disinfected upon completion? <input type="checkbox"/> Yes <input checked="" type="checkbox"/> No		
(Use a second sheet if needed)			17. Pump: Manufacturer's name <b>Dempster</b> Not installed Model number <b>Demo</b> HP <b>1/2</b> Volts <b>115</b> Length of drop pipe <b>36</b> ft. capacity <b>15</b> g.p.m. Type: <input checked="" type="checkbox"/> Submersible <input type="checkbox"/> Turbine <input type="checkbox"/> Jet <input type="checkbox"/> Reciprocating <input type="checkbox"/> Centrifugal <input type="checkbox"/> Other		
18. Elevation: Topography: <input type="checkbox"/> Hill <input type="checkbox"/> Slope <input type="checkbox"/> Upland <input type="checkbox"/> Valley	19. Remarks:		20. Water well contractor's certification: This well was drilled under my jurisdiction and this report is true to the best of my knowledge and belief. <b>PAUL'S INC #175</b> Business name License No. Address <b>Box 26 Hessley KS</b> Signed <b>Paul B. Buel</b> Date <b>5/28/79</b> Authorized representative		