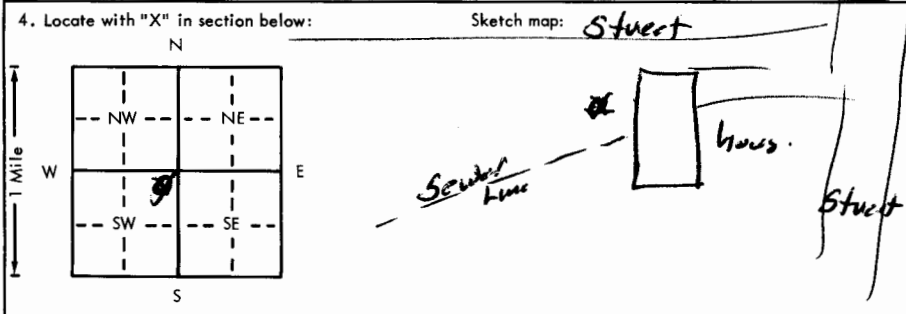


USE TYPEWRITER OR BALL
POINT PEN-PRESS FIRMLY,
PRINT CLEARLY.

WATER WELL RECORD
KSA 82a-1201-1215

Kansas Department of Health and
Environment-Division of Environment
(Water well Contractors)
Topeka, Kansas 66620

1. Location of well:		County HARVEY	Fraction NE 1/4 NE 1/4 SW 1/4	Section number 16	Township number T 22 S R 1 E	Range number 1
2. Distance and direction from nearest town or city: SAME				3. Owner of well: ISAURO MENDEZ R.R. or street: 205 LANCASTER City, state and zip code: HESSON, KS		
4. Locate with "X" in section below: 				5. Bore hole dia. 4 1/2 in. Completion date 9-11-78 Well depth 38 ft.		
6. Use: <input checked="" type="checkbox"/> Domestic <input type="checkbox"/> Public supply <input type="checkbox"/> Industry <input checked="" type="checkbox"/> Irrigation <input type="checkbox"/> Air conditioning <input type="checkbox"/> Stock <input checked="" type="checkbox"/> Lawn <input type="checkbox"/> Oil field water <input type="checkbox"/> Other				7. Cable tool <input checked="" type="checkbox"/> Rotary <input type="checkbox"/> Driven <input type="checkbox"/> Dug <input type="checkbox"/> Hollow rod <input type="checkbox"/> Jetted <input type="checkbox"/> Bored <input type="checkbox"/> Reverse rotary		
8. Casing: Material PVC Height: 24 or below Threaded <input type="checkbox"/> Welded <input checked="" type="checkbox"/> Surface 24 in. RMP <input type="checkbox"/> PVC <input checked="" type="checkbox"/> Weight 3.62 lbs./ft. Dia. 6 in. to 38 ft. depth Wall Thickness: inches or Dia. 6 in. to 38 ft. depth gage No. 280				9. Screen: Manufacturer's name OWN Slot Type PVC Dia. 6 1/4 Slot/gauze .046 Length 20' Set between 15 ft. and 35 ft. Gravel pack? <input checked="" type="checkbox"/> Size range of material 1/8-1/4		
10. Static water level: 15 ft. below land surface Date 8/18/78				11. Pumping level below land surfaces: 38 ft. after 3 hrs. pumping 5 g.p.m. 38 ft. after hrs. pumping g.p.m. Estimated maximum yield 5 g.p.m.		
12. Water sample submitted: Yes <input checked="" type="checkbox"/> No <input type="checkbox"/> Date 8/18/78				13. Well head completion: <input checked="" type="checkbox"/> Pitless adapter 24 inches above grade		
14. Well grouted? <input checked="" type="checkbox"/> With: <input checked="" type="checkbox"/> Neat cement <input type="checkbox"/> Bentonite <input type="checkbox"/> Concrete Depth: From 10 ft. to 0 ft.				15. Nearest source of possible contamination: house ft. 20 Direction South Type sewer line Well disinfected upon completion? Yes <input checked="" type="checkbox"/> No <input type="checkbox"/>		
16. Pump: Manufacturer's name Dempster Model number MC-33-50 1/3 Volts 230 Length of drop pipe 33 ft. capacity 8 g.p.m. Type: <input checked="" type="checkbox"/> Submersible <input type="checkbox"/> Turbine <input type="checkbox"/> Jet <input type="checkbox"/> Reciprocating <input type="checkbox"/> Centrifugal <input type="checkbox"/> Other				17. Water well contractor's certification: This well was drilled under my jurisdiction and this report is true to the best of my knowledge and belief. PAULIS INC #175 Business name License No. Address HESSON, KS Signed Paul Bullard Date 9/14/78 Authorized representative		
18. Elevation:		19. Remarks:		20. (Use a second sheet if needed)		
Topography: <input type="checkbox"/> Hill <input type="checkbox"/> Slope <input type="checkbox"/> Upland <input type="checkbox"/> Valley						