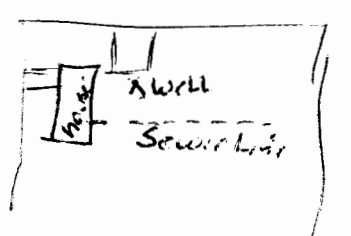


USE TYPEWRITER OR BALL  
POINT PEN-PRESS FIRMLY,  
PRINT CLEARLY.

WATER WELL RECORD  
KSA 82a-1201-1215

Kansas Department of Health and  
Environment-Division of Environment  
(Water well Contractors)  
Topeka, Kansas 66620

1. Location of well:		County <b>HARVEY</b>	Fraction <b>NE 1/4 NW 1/4 SW 1/4</b>	Section number <b>16</b>	Township number <b>T 22 S R 1 E</b>	Range number <b>1 E</b>	
2. Distance and direction from nearest town or city: Street address of well location if in city: <b>SAME</b>			3. Owner of well: <b>RANDY ZEPHER</b> R.R. or street: <b>200 S LANCASTER</b> City, state, zip code: <b>HESSLEY KANSAS 67061</b>				
4. Locate with "X" in section below: N W E S 1 Mile 1 Mile		Sketch map: 		6. Bore hole dia. <b>12</b> in. Completion date <b>8/2/26</b> Well depth <b>33</b> ft.			
5. Type and color of material		From		To		7. <input checked="" type="checkbox"/> Cable tool <input checked="" type="checkbox"/> Rotary <input type="checkbox"/> Driven <input type="checkbox"/> Dug <input type="checkbox"/> Hollow rod <input type="checkbox"/> Jetted <input type="checkbox"/> Bored <input type="checkbox"/> Reverse rotary	
		Loom		0		5	
		Loom to red clay		5		10	
		grey clay		10		13	
		Alkali clay		13		15	
Sandy clay		15		17			
SAND (with clay)		17		21			
grey-green shale		21		25			
grey shale		25		30			
dark shale		30		33			
(Use a second sheet if needed)		10. Screen: Manufacturer's name <b>Robin-Tech - Down Shot</b>		11. Static water level: <b>12</b> ft. below land surface Date <b>8/2/26</b>			
		Type <b>Down Shot</b> Dia. <b>6"</b>		12. Pumping level below land surfaces: <b>23</b> ft. after <b>1</b> hrs. pumping <b>10</b> g.p.m. <b>30</b> ft. after <b>1</b> hrs. pumping <b>10</b> g.p.m. Estimated maximum yield <b>10</b> g.p.m.			
		Slot/gauze <b>0.064</b> Length <b>10'</b>		13. Water sample submitted: <b>Yes</b> <input checked="" type="checkbox"/> No <input type="checkbox"/> Date <b>8/2/26</b>			
		Set between <b>15</b> ft. and <b>25</b> ft. ft. and ft.		14. Well head completion: <input type="checkbox"/> Pitless adapter <b>12</b> inches above grade			
		Gravel pack? <input checked="" type="checkbox"/> Size range of material <b>1/2 - 3/4</b>		15. Well grouted? <input checked="" type="checkbox"/> With: <input checked="" type="checkbox"/> Neat cement <input type="checkbox"/> Bentonite <input type="checkbox"/> Concrete Depth: From <b>0</b> ft. to <b>10</b> ft.			
18. Elevation: Topography: <input type="checkbox"/> Hill <input type="checkbox"/> Slope <input type="checkbox"/> Upland <input type="checkbox"/> Valley		16. Nearest source of possible contamination: <b>house</b> ft. <b>30</b> Direction <b>South</b> Type <b>Sanitary</b>		17. Pump: <input checked="" type="checkbox"/> Not installed Manufacturer's name <b>PAUL'S TALK</b> License No. <b>175</b> Model number <b>400 LAN</b> HP <b>1/2</b> Volts <b>115</b> Length of drop pipe <b>30</b> ft. capacity <b>10</b> g.p.m. Type: <input type="checkbox"/> Submersible <input type="checkbox"/> Turbine <input type="checkbox"/> Jet <input type="checkbox"/> Reciprocating <input type="checkbox"/> Centrifugal <input type="checkbox"/> Other			
		19. Remarks:		20. Water well contractor's certification: This well was drilled under my jurisdiction and this report is true to the best of my knowledge and belief. <b>PAUL'S TALK</b> <b>175</b> Business name License No. Address <b>400 LAN. HESSLEY, KANS.</b> Signed <b>Paul B. ...</b> Date <b>8/2/26</b> Authorized representative			

22-16 NE 1/4 SW 1/4