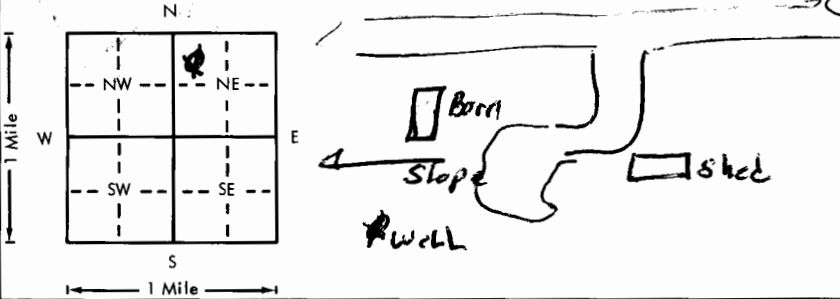


USE TYPEWRITER OR BALL
POINT PEN-PRESS FIRMLY,
PRINT CLEARLY.

WATER WELL RECORD
KSA 82a-1201-1215

Kansas Department of Health and
Environment-Division of Environment
(Water well Contractors)
Topeka, Kansas 66620

1. Location of well:		County HARVEY	Fraction W/2 NE 1/4	Section number 18	Township number T 22	Range number S 1 R 1
2. Distance and direction from nearest town or city: Street address of well location if in city:		2 M WEST of HESSTON		3. Owner of well: R.R. or street: City, state, zip code:		
				STAN ROUPP 110 S. Roupp Street HESSTON, KNS		
4. Locate with "X" in section below:		Sketch map:		6. Bore hole dia. 14 in. Completion date 10-11-77 Well depth 40 ft.		
				7. <input checked="" type="checkbox"/> Cable tool <input checked="" type="checkbox"/> Rotary <input type="checkbox"/> Driven <input type="checkbox"/> Dug <input type="checkbox"/> Hollow rod <input type="checkbox"/> Jetted <input type="checkbox"/> Bored <input type="checkbox"/> Reverse rotary		
5. Type and color of material		From		To		8. Use: <input checked="" type="checkbox"/> Domestic <input type="checkbox"/> Public supply <input type="checkbox"/> Industry <input checked="" type="checkbox"/> Irrigation <input type="checkbox"/> Air conditioning <input type="checkbox"/> Stock <input checked="" type="checkbox"/> Lawn <input type="checkbox"/> Oil field water <input type="checkbox"/> Other
LOAM TO CLAY		0		5		9. Casing: Material PVC Height: Above or below Threaded <input type="checkbox"/> Welded <input type="checkbox"/> Surface 24 in. RMP <input type="checkbox"/> PVC <input checked="" type="checkbox"/> Weight 10 lbs./ft. Dia. 8 in. to 40 ft. depth Wall Thickness: inches or Dia. <input type="checkbox"/> in. to <input type="checkbox"/> ft. depth gage No. 6322
BR CLAY TO RED CLAY		5		10		10. Screen: Manufacturer's name OWN SLOT 1046 Type PVC Dia. 8" Slot/gauze 1046 Length 8' Set between 24 ft. and 32 ft. Gravel pack? <input checked="" type="checkbox"/> Size range of material 1/8-1/4
RED CLAY		10		15		11. Static water level: 14 ft. below land surface Date 10-11-77
LIGHT BROWN CLAY		15		20		12. Pumping level below land surfaces: 40 ft. after 2 hrs. pumping 12 g.p.m. ft. after <input type="checkbox"/> hrs. pumping <input type="checkbox"/> g.p.m. Estimated maximum yield 12 g.p.m.
SANDY BROWN CLAY		20		23		13. Water sample submitted: <input checked="" type="checkbox"/> Yes <input type="checkbox"/> No Date 10-11-77
SAND (brown)		23		25		14. Well head completion: 24 inches above grade Pitless adapter <input type="checkbox"/> Pitless adapter <input type="checkbox"/> Pitless adapter <input type="checkbox"/>
BROWN CLAY		25		27		15. Well grouted? NO With: <input type="checkbox"/> Neat cement <input type="checkbox"/> Bentonite <input type="checkbox"/> Concrete Depth: From <input type="checkbox"/> ft. to <input type="checkbox"/> ft.
SAND (with clay balls)		27		32		16. Nearest source of possible contamination: Neighboring ft. 650 Direction East Type Logan Well disinfected upon completion? <input type="checkbox"/> Yes <input checked="" type="checkbox"/> No
GREEN GRAY SHALE		32		35		17. Pump: <input checked="" type="checkbox"/> Not installed Manufacturer's name <input type="checkbox"/> Model number <input type="checkbox"/> HP <input type="checkbox"/> Volts <input type="checkbox"/> Length of drop pipe <input type="checkbox"/> ft. capacity <input type="checkbox"/> g.p.m. Type: <input type="checkbox"/> Submersible <input type="checkbox"/> Turbine <input type="checkbox"/> Jet <input type="checkbox"/> Reciprocating <input type="checkbox"/> Centrifugal <input type="checkbox"/> Other
LIGHT GRAY SHALE		35		40		20. Water well contractor's certification: This well was drilled under my jurisdiction and this report is true to the best of my knowledge and belief. PAUL'S INC. #175 Business name Box 26 Hesston, KNS License No. 11/2/77 Address Paul Bumbhart Signed 11/2/77 Authorized representative
18. Elevation:		19. Remarks:				
Topography: <input type="checkbox"/> Hill <input type="checkbox"/> Slope <input type="checkbox"/> Upland <input type="checkbox"/> Valley		Owner to grout well				