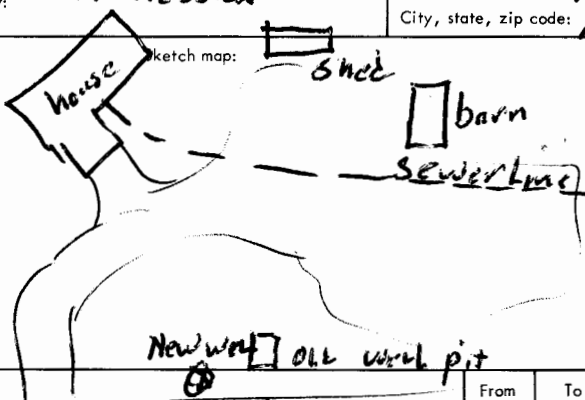


USE TYPEWRITER OR BALL  
POINT PEN-PRESS FIRMLY,  
PRINT CLEARLY.

WATER WELL RECORD  
KSA 82a-1201-1215

Kansas Department of Health and  
Environment-Division of Environment  
(Water well Contractors)  
Topeka, Kansas 66620

1. Location of well:		County <b>HARVEY</b>	Fraction <b>NW 1/4 NE 1/4 NE 1/4</b>	Section number <b>18</b>	Township number <b>T 22 S R 1 E</b>	Range number <b>1</b>
2. Distance and direction from nearest town or city: Street address of well location if in city:		<b>1 1/2 mile West of Hesston</b>		3. Owner of well: R.R. or street: City, state, zip code:		
				<b>STAN ROUPP</b> <b>110 S Rouppe St.</b> <b>Hesston, KS 67062</b>		
4. Locate with "X" in section below: N W E S 1 Mile		Sketch map: 		6. Bore hole dia. <b>11</b> in. Completion date Well depth <b>103</b> ft. <b>3/29/79</b>		
5. Type and color of material		From		To		7. Cable tool <input checked="" type="checkbox"/> Rotary <input type="checkbox"/> Driven <input type="checkbox"/> Dug <input type="checkbox"/> Hollow rod <input type="checkbox"/> Jetted <input type="checkbox"/> Bored <input type="checkbox"/> Reverse rotary
dark brown		0		2		8. Use: <input checked="" type="checkbox"/> Domestic <input type="checkbox"/> Public supply <input type="checkbox"/> Industry <input type="checkbox"/> Irrigation <input type="checkbox"/> Air conditioning <input type="checkbox"/> Stock <input checked="" type="checkbox"/> Lawn <input type="checkbox"/> Oil field water <input type="checkbox"/> Other
light grey clay		2		6		9. Casing: Material <b>plastic</b> Height (Above or below Threaded <input type="checkbox"/> Welded <input checked="" type="checkbox"/> Surface <b>18</b> in. RMP <input type="checkbox"/> PVC <input checked="" type="checkbox"/> Weight <b>3.59</b> lbs./ft. Dia. <b>6</b> in. to <b>103</b> ft. depth Wall Thickness: inches or Dia. <input type="checkbox"/> in. to <input type="checkbox"/> ft. depth gauge No. <b>280</b>
light brown sandy clay		6		23		10. Screen: Manufacturer's name <b>pumpco - own slot</b> Type <b>pvc</b> Dia. <b>6"</b> Slot/gauze <b>1/4"</b> Length <b>30'</b> Set between <b>22</b> ft. and <b>32</b> ft. <b>74</b> ft. and <b>94</b> ft. Gravel pack? <input checked="" type="checkbox"/> Size range of material <b>1/4"/1/8"</b>
light brown med-fine sand		23		26		11. Static water level: <b>22'</b> ft. below land surface Date <b>3/29/79</b>
Red Shale		26		28		12. Pumping level below land surfaces: ft. after <input type="checkbox"/> hrs. pumping <input type="checkbox"/> g.p.m. <b>25'</b> ft. after <b>2</b> hrs. pumping <b>8</b> g.p.m. Estimated maximum yield <b>8</b> g.p.m.
Red + light green soft shale		28		35		13. Water sample submitted: <input type="checkbox"/> Yes <input checked="" type="checkbox"/> No Date
light green to grey " "		35		50		14. Well head completion: <input checked="" type="checkbox"/> Pitless adapter <b>18"</b> inches above grade
blue grey shale		50		76		15. Well grouted? <input checked="" type="checkbox"/> <b>by owner</b> With: <input checked="" type="checkbox"/> Neat cement <input type="checkbox"/> Bentonite <input type="checkbox"/> Concrete Depth: From <b>0</b> ft. to <b>10</b> ft.
yellow (olive) green soft shale		76		78		16. Nearest source of possible contamination: <b>house</b> ft. <b>60</b> Direction <b>sewer</b> Type <b>sewer</b> Well disinfected upon completion? <input checked="" type="checkbox"/> Yes <input type="checkbox"/> No
blue grey shale (dark)		78		103		17. Pump: <input checked="" type="checkbox"/> Not installed Manufacturer's name Model number <input type="checkbox"/> HP <input type="checkbox"/> Volts <input type="checkbox"/> Length of drop pipe <input type="checkbox"/> ft. capacity <input type="checkbox"/> g.p.m. Type: <input type="checkbox"/> Submersible <input type="checkbox"/> Turbine <input type="checkbox"/> Jet <input type="checkbox"/> Reciprocating <input type="checkbox"/> Centrifugal <input type="checkbox"/> Other
18. Elevation:		19. Remarks:		20. Water well contractor's certification: This well was drilled under my jurisdiction and this report is true to the best of my knowledge and belief. <b>Paul's Inc. #175</b> Business name <b>Bex 26 Hesston</b> License No. Address <b>Paul Paulat</b> Date <b>3/29/79</b> Signed <b>Paul Paulat</b> Authorized representative		