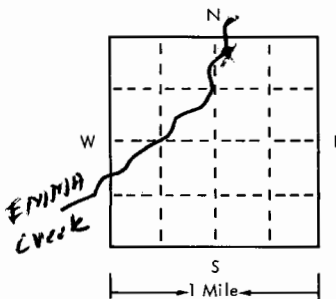


USE TYPEWRITER OR BALL  
POINT PEN-PRESS FIRMLY,  
PRINT CLEARLY.

WATER WELL RECORD  
KSA 82a-1201-1215

T R EW sec 1/4 1/4 1/4 No.

Kansas State Dept. Of Health  
(Water Well Contractors)  
Forbes-Bldg. 740  
Topeka, Kansas 66620

|  |                         |                              |  |   |   |   |   |  |
|--|-------------------------|------------------------------|--|---|---|---|---|--|
| 1 Location of well:  | County<br><b>HARVEY</b> | Township name<br><b>EMMA</b> | Fraction<br><b>NW 1/4 NE 1/4</b>   | Section number<br><b>18</b>   | Town number<br><b>T-22-S</b>  | Range number<br><b>R-1-W</b>  |   |  |
| Distance and direction from nearest town or city:<br><b>2 Miles West of Hesston</b>  |                         |                              | 3 Owner of well:<br><b>STAN CLARK</b><br>Address:<br><b>WOODCREST VILLAGE PARK</b><br><b>HESSTON, KANSAS</b> |   |   |   |   |  |
| Locate with "X" in section below:<br>  |                         |                              | Sketch map:  |   |   | 4 Well depth: <b>48</b> ft. Date of completion <b>5/27/75</b><br>Well diameter <b>12"</b> in. |   |  |
| 2<br>Type and color of material  |                         |                              | From   | To  | 5 <input type="checkbox"/> Cable tool <input checked="" type="checkbox"/> Rotary <input type="checkbox"/> Driven <input type="checkbox"/> Dug<br><input type="checkbox"/> Hollow rod <input type="checkbox"/> Jetted <input type="checkbox"/> Bored <input type="checkbox"/> Reverse rotary |   |   |  |
|  |                         |                              | Sandy loam (dune type)   |   | 0   | 5   | 6 Use: <input checked="" type="checkbox"/> Domestic <input type="checkbox"/> Public supply <input type="checkbox"/> Industry<br><input type="checkbox"/> Irrigation <input type="checkbox"/> Air conditioning <input type="checkbox"/> Commercial<br><input type="checkbox"/> Test well <input type="checkbox"/>                            |  |
|  |                         |                              | brown clay   |   | 5   | 10  | 7 Casing: Material <b>PVC</b> Height: <b>above</b> below<br>Threaded <input type="checkbox"/> Welded <input checked="" type="checkbox"/> Surface <b>12</b> in.<br>Diam. <b>6 1/2"</b> to <b>48</b> ft. depth Drive shoe? <input type="checkbox"/> Yes <input checked="" type="checkbox"/> No<br><b>6 1/2"</b> in. to <b>48</b> ft. depth    |  |
|  |                         |                              | " " to dark clay   |   | 10  | 15  | 8 Screen: <b>CENT-TECH</b><br>Manufacturer <b>OWN SLOT</b><br>Type <b>PVC</b> Dia. <b>6 1/2"</b><br>Slot/gauze <b>1/4" x 1/8"</b> Length <b>60</b><br>Set between <b>20</b> ft. and <b>35</b> ft.<br>Fittings: <b>1/2" - 3/8"</b><br>Gravel pack <input checked="" type="checkbox"/> Yes <input type="checkbox"/> No Size range of material |  |
|  |                         |                              | dark clay to sandy clay  |   | 15  | 20  | 9 Static water level:<br><b>18</b> ft. below land surface Date <b>5/27/75</b>   |  |
|  |                         |                              | SAND + clay (layers & mix)   |   | 20  | 23  | 10 Pumping level below land surfaces:<br><b>2 1/2</b> ft. after <b>1</b> hrs. pumping <b>20</b> g.p.m.<br>____ ft. after ____ hrs. pumping ____ g.p.m.<br>Estimated maximum yield <b>25</b> g.p.m.  |  |
|  |                         |                              | SAND med coarse  |   | 23  | 30  | 11 Water sample submitted:<br><input type="checkbox"/> Yes <input checked="" type="checkbox"/> No Date ____   |  |
|  |                         |                              | green-grey shale   |   | 30  | 31  | 12 Well head completion:<br><input type="checkbox"/> Pitless adapter <input checked="" type="checkbox"/> Inches above grade   |  |
|  |                         |                              | dark shale   |   | 31  | 32  | 13 Well grouted? <input checked="" type="checkbox"/> Yes <input type="checkbox"/> No<br><input checked="" type="checkbox"/> Neat cement <input type="checkbox"/> Bentonite <input type="checkbox"/><br>Depth: From <b>18</b> ft. to <b>0</b> ft.  |  |
|  |                         |                              | SAND - med   |   | 32  | 35  | 14 Nearest source of possible contamination:<br>ft. ____ Direction <b>UNKNOWN</b> Type ____<br>Well disinfected upon completion? <input checked="" type="checkbox"/> Yes <input type="checkbox"/> No  |  |
| dark shale   |                         | 35                           | 36   | 15 Pump: <input checked="" type="checkbox"/> Not installed<br>Manufacturer's name ____<br>Model number ____ HP ____ Volts ____<br>Length of drop pipe ____ ft. capacity ____ g.p.m.<br>Type:<br><input type="checkbox"/> Submersible <input type="checkbox"/> Turbine<br><input type="checkbox"/> Jet <input type="checkbox"/> Reciprocating<br><input type="checkbox"/> Centrifugal <input type="checkbox"/> Other |   |   |   |  |
| grey-white clay (semi-soft shale)  |                         | 36                           | 40   | 17 Water well contractor's certification:<br>This well was drilled under my jurisdiction and this report is true to the best of my knowledge and belief.<br><b>PAULS INC #175</b><br>Business name License No.<br>Address <b>400 N LANCASTER - HESSTON</b><br>Signed <b>Paul B. Pauls</b> Date <b>5/27/75</b><br>Authorized representative  |   |   |   |  |
| Semi-soft grey shale to dark hard  |                         | 40                           | 48   |   |   |   |   |  |
| 16 Remarks: elevation<br>Topography:<br><input type="checkbox"/> Hill<br><input checked="" type="checkbox"/> Slope<br><input type="checkbox"/> Upland<br><input type="checkbox"/> Valley<br>(use a second sheet if needed) |                         |                              |  |   |   |   |   |  |