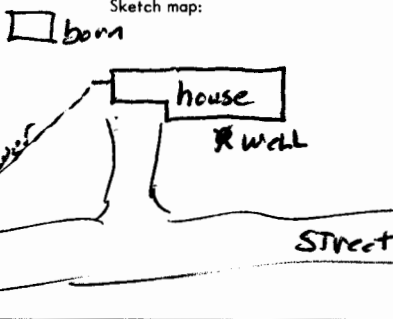


USE TYPEWRITER OR BALL
POINT PEN-PRESS FIRMLY,
PRINT CLEARLY.

WATER WELL RECORD
KSA 82a-1201-1215

Kansas Department of Health and
Environment-Division of Environment
(Water well Contractors)
Topeka, Kansas 66620

1. Location of well:		County HARVEY	Fraction NE 1/4 NE 1/4 NE 1/4	Section number 18	Township number T 22 S	Range number R 1 E
2. Distance and direction from nearest town or city: Street address of well location if in city:			3. Owner of well: SAM EDIGER R.R. or street: RR #1 City, state, zip code: HESSON, KS			
4. Locate with "X" in section below: N W E S 1 Mile 1 Mile			Sketch map: 			
5. Type and color of material			From	To	6. Bore hole dia. 4 in. Completion date 3/31/78 Well depth 45 ft.	
LOAM TO BROWN CLAY			0	5	7. Cable tool <input checked="" type="checkbox"/> Rotary <input type="checkbox"/> Driven <input type="checkbox"/> Dug <input type="checkbox"/> Hollow rod <input type="checkbox"/> Jetted <input type="checkbox"/> Bored <input type="checkbox"/> Reverse rotary	
BROWN to RED to GREY CLAY			5	10	8. Use: <input checked="" type="checkbox"/> Domestic <input type="checkbox"/> Public supply <input type="checkbox"/> Industry <input type="checkbox"/> Irrigation <input type="checkbox"/> Air conditioning <input type="checkbox"/> Stock <input type="checkbox"/> Lawn <input type="checkbox"/> Oil field water <input type="checkbox"/> Other	
BROWN - GREY CLAY (1 alkali layer)			10	15	9. Casing: Material plastic Height above or below Threaded <input type="checkbox"/> Welded <input type="checkbox"/> Surface 24 in. RMP <input type="checkbox"/> PVC <input checked="" type="checkbox"/> Weight 2.76 lbs./ft. Dia. 5 in. to 45 ft. depth Wall Thickness: inches or Dia. <input type="checkbox"/> in. to <input type="checkbox"/> ft. depth gage No. 125B	
SAND - MEDIUM to COARSE			15	30	10. Screen: Manufacturer's name Western Type PVC Dia. 5" Slot/gauze .046 Length 20' Set between 25 ft. and 45 ft. Gravel pack? <input checked="" type="checkbox"/> Size range of material #1 course	
SAND - FINE to MEDIUM			30	35	11. Static water level: 10 ft. below land surface Date 3/31/78 mo./day/yr.	
SAND - COARSE			35	42	12. Pumping level below land surfaces: 13 ft. after 1 1/2 hrs. pumping 18 g.p.m. 13 ft. after 1 1/2 hrs. pumping 18 g.p.m. Estimated maximum yield 60 g.p.m.	
SHALE - green - grey			42	45	13. Water sample submitted: Yes <input checked="" type="checkbox"/> No <input type="checkbox"/> Date 3/31/78 mo./day/yr.	
					14. Well head completion: <input checked="" type="checkbox"/> Pitless adapter <input type="checkbox"/> _____ Inches above grade	
					15. Well grouted? <input checked="" type="checkbox"/> With: <input checked="" type="checkbox"/> Neat cement <input type="checkbox"/> Bentonite <input type="checkbox"/> Concrete Depth: From 12 ft. to 0 ft.	
					16. Nearest source of possible contamination: sewer ft. SW Direction 25 Type line Well disinfected upon completion? <input checked="" type="checkbox"/> Yes <input type="checkbox"/> No	
					17. Pump: Manufacturer's name Dempster Model number M43-32 HP 1/2 Volts 115 Length of drop pipe 35 ft. capacity 12 g.p.m. Type: <input checked="" type="checkbox"/> Submersible <input type="checkbox"/> Turbine <input type="checkbox"/> Jet <input type="checkbox"/> Reciprocating <input type="checkbox"/> Centrifugal <input type="checkbox"/> Other	
					20. Water well contractor's certification: This well was drilled under my jurisdiction and this report is true to the best of my knowledge and belief. PAUL'S INC #175 Business name HESSON, KS License No. 4/8/78 Address Paul Brant Signed Paul Brant Date 4/8/78 Authorized representative	
18. Elevation:		19. Remarks:				
Topography: <input type="checkbox"/> Hill <input type="checkbox"/> Slope <input type="checkbox"/> Upland <input type="checkbox"/> Valley						