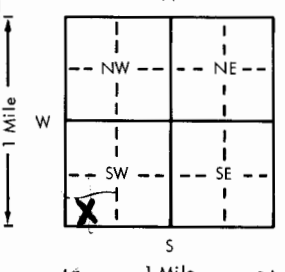
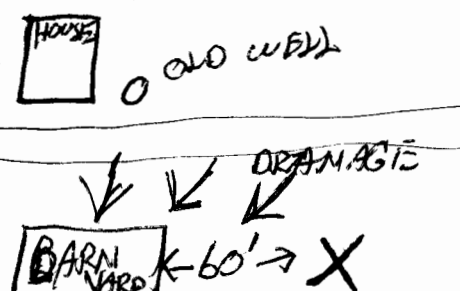


USE TYPEWRITER OR BALL  
POINT PEN-PRESS FIRMLY,  
PRINT CLEARLY.

WATER WELL RECORD  
KSA 82a-1201-1215

Kansas Department of Health and  
Environment-Division of Environment  
(Water well Contractors)  
Topeka, Kansas 66620

1. Location of well:		County <b>HARVEY</b>	Fraction <b>SE 1/4 SW 1/4 SW 1/4</b>	Section number <b>22</b>	Township number <b>T 22-5 S</b>	Range number <b>R 1-W E/W</b>
2. Distance and direction from nearest town or city: Street address of well location if in city:		<b>1 mile S.</b> <b>1/4 E FROM HESSTON</b>		3. Owner of well: <b>ALLEN SCHRAG</b> R.R. or street: <b>RR #</b> City, state, zip code: <b>HASTED KANS. 67056</b>		
4. Locate with "X" in section below:		Sketch map:		6. Bore hole dia. <b>8</b> in. Completion date <b>10-9-78</b> Well depth <b>58</b> ft.		
				7. <input checked="" type="checkbox"/> Cable tool <input checked="" type="checkbox"/> Rotary <input type="checkbox"/> Driven <input type="checkbox"/> Dug <input type="checkbox"/> Hollow rod <input type="checkbox"/> Jetted <input type="checkbox"/> Bored <input type="checkbox"/> Reverse rotary		
5. Type and color of material		From		To		8. Use: <input checked="" type="checkbox"/> Domestic <input type="checkbox"/> Public supply <input type="checkbox"/> Industry <input type="checkbox"/> Irrigation <input type="checkbox"/> Air conditioning <input type="checkbox"/> Stock <input type="checkbox"/> Lawn <input type="checkbox"/> Oil field water <input type="checkbox"/> Other
<b>CLAY</b>		<b>0</b>		<b>6</b>		9. Casing: Material <input type="checkbox"/> Height Above or below Threaded <input type="checkbox"/> Welded <input type="checkbox"/> Surface <b>12</b> in. RMP <input checked="" type="checkbox"/> PVC <input type="checkbox"/> Weight <input type="checkbox"/> lbs./ft.
<b>FINE SAND</b>		<b>6</b>		<b>10</b>		Dia. <b>5</b> in. to <b>58</b> ft. depth Wall Thickness: inches or Dia. <input type="checkbox"/> in. to <input type="checkbox"/> ft. depth gage No. <b>1200</b>
<b>CLAY - BROWN</b>		<b>10</b>		<b>17</b>		10. Screens: Manufacturer's name <b>SENPOWER PLAS. PIPE</b>
<b>CLAY - GRAY</b>		<b>17</b>		<b>30</b>		Type <b>1200</b> Dia. <b>5</b> Slot gauge <b>1/8</b> Length <b>20</b> Set between <b>38</b> ft. and <b>58</b> ft.
<b>CLAY - DARK GRAY</b>		<b>30</b>		<b>45</b>		Gravel pack? <input checked="" type="checkbox"/> Size range of material <b>1/4-1/2</b>
<b>CLAY + SAND - MEAN TO COURSE</b>		<b>45</b>		<b>54</b>		11. Static water level: <input type="checkbox"/> mo./day/yr. <b>24</b> ft. below land surface Date <input type="checkbox"/>
<b>SHALE</b>		<b>54</b>		<b>58</b>		12. Pumping level below land surfaces: <input type="checkbox"/> ft. after <input type="checkbox"/> hrs. pumping <input type="checkbox"/> g.p.m. <input type="checkbox"/> ft. after <input type="checkbox"/> hrs. pumping <input type="checkbox"/> g.p.m. Estimated maximum yield <b>8</b> g.p.m.
						13. Water sample submitted: <input type="checkbox"/> mo./day/yr. <input type="checkbox"/> Yes <input checked="" type="checkbox"/> No Date <input type="checkbox"/>
						14. Well head completion: <input type="checkbox"/> Pitless adapter <b>12</b> Inches above grade
						15. Well grouted? <b>YES</b> With: <input type="checkbox"/> Neat cement <input type="checkbox"/> Bentonite <input checked="" type="checkbox"/> Concrete Depth: From <b>0</b> ft. to <b>10</b> ft.
						16. Nearest source of possible contamination: ft. <b>60</b> Direction <b>S</b> Type <b>BARN YARD</b> Well disinfected upon completion? <input checked="" type="checkbox"/> Yes <input type="checkbox"/> No
						17. Pump: Not installed Manufacturer's name <b>GOUZOS</b> Model number <b>1050712</b> HP <b>10</b> Volts <b>230</b> Length of drop pipe <b>58</b> ft. capacity <b>10</b> g.p.m. Type: <input checked="" type="checkbox"/> Submersible <input type="checkbox"/> Turbine <input type="checkbox"/> Jet <input type="checkbox"/> Reciprocating <input type="checkbox"/> Centrifugal <input type="checkbox"/> Other
18. Elevation:		19. Remarks:		20. Water well contractor's certification: This well was drilled under my jurisdiction and this report is true to the best of my knowledge and belief. <b>MARTIN SUPPLY</b> <b>362</b> Business name License No. Address <b>500 W 22ND AVE</b> Signed <b>Burt Schuch</b> Date <b>10-2-78</b> Authorized representative		