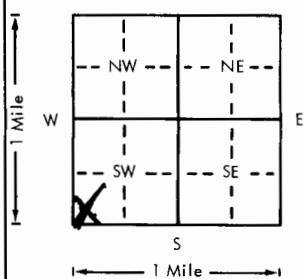


USE TYPEWRITER OR BALL
POINT PEN-PRESS FIRMLY,
PRINT CLEARLY.

WATER WELL RECORD
KSA 82a-1201-1215

Kansas Department of Health and
Environment-Division of Environment
(Water well Contractors)
Topeka, Kansas 66620

1. Location of well:		County HARVEY	Fraction SW 1/4 SW 1/4 SW 1/4	Section number 25	Township number T 22 S	Range number R 1 W E 1/4
2. Distance and direction from nearest town or city: Street address of well location if in city:				3. Owner of well: Kansas Crop Service Inc. R.R. or street: Zimmerdale Kansas City, state, zip code:		
4. Locate with "X" in section below: 				6. Bore hole dia. 10.00 in. Completion date 5-20-78 Well depth 40 ft.		
				7. <input checked="" type="checkbox"/> Cable tool <input checked="" type="checkbox"/> Rotary <input type="checkbox"/> Driven <input type="checkbox"/> Dug <input type="checkbox"/> Hollow rod <input type="checkbox"/> Jetted <input type="checkbox"/> Bored <input type="checkbox"/> Reverse rotary		
				8. Use: <input type="checkbox"/> Domestic <input type="checkbox"/> Public supply <input checked="" type="checkbox"/> Industry <input type="checkbox"/> Irrigation <input type="checkbox"/> Air conditioning <input type="checkbox"/> Stock <input type="checkbox"/> Lawn <input type="checkbox"/> Oil field water <input type="checkbox"/> Other		
				9. Casing: Material PIST Height 24 in. Above or below Threaded <input type="checkbox"/> Welded <input checked="" type="checkbox"/> Surface 24 in. RMP <input checked="" type="checkbox"/> PVC <input type="checkbox"/> Weight <input type="checkbox"/> lbs./ft. Dia. 5 in. to 40 ft. depth Wall Thickness: inches or Dia. <input type="checkbox"/> in. to <input type="checkbox"/> ft. depth gage No. TYPE 200		
5. Type and color of material				From	To	10. Screen: Manufacturer's name SUNFLOWER PIST PIPE
FINE SAND				0	4	Type 200 Dia. 5 IN.
CLAY				4	10	Slot/gauze 10 Length 40
FINE TO COURSE SAND				10	18	Set between 20 ft. and 40 ft.
VERY COURSE SAND + GRAVEL				18	38	Gravel pack? <input checked="" type="checkbox"/> Size range of material
HARD SHALE				38	40	
						11. Static water level: 19 ft. below land surface Date 5-7-78
						12. Pumping level below land surfaces: ____ ft. after ____ hrs. pumping ____ g.p.m. ____ ft. after ____ hrs. pumping ____ g.p.m. Estimated maximum yield ____ g.p.m.
						13. Water sample submitted: ____ mo./day/yr. ____ Yes <input checked="" type="checkbox"/> No Date ____
						14. Well head completion: <input checked="" type="checkbox"/> Pitless adapter 24 inches above grade
						15. Well grouted? YES With: ____ Neat cement ____ Bentonite <input checked="" type="checkbox"/> Concrete Depth: From 3.5 ft. to 15 ft.
						16. Nearest source of possible contamination: ft. 150 Direction SE Type FERTILIZER Well disinfected upon completion? ____ Yes <input checked="" type="checkbox"/> No
						17. Pump: <input checked="" type="checkbox"/> Not installed Manufacturer's name GOODY Model number 10E1512 HP 1/2 Volts 230 Length of drop pipe 35 ft. capacity 10 g.p.m. Type: <input checked="" type="checkbox"/> Submersible ____ Turbine ____ Jet ____ Reciprocating ____ Centrifugal ____ Other
						20. Water well contractor's certification: This well was drilled under my jurisdiction and this report is true to the best of my knowledge and belief. MARTIN SUPPLY 362 Business name 500 W 28th North License No. 530 Address Butch Schmid Date 5/20/78 Signed Butch Schmid Authorized representative
18. Elevation:		19. Remarks:				
Topography: ____ Hill ____ Slope <input checked="" type="checkbox"/> Upland ____ Valley						