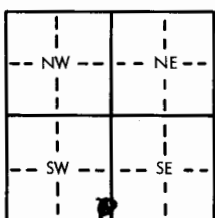
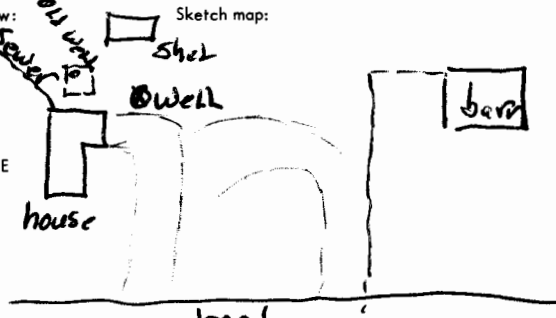


USE TYPEWRITER OR BALL
POINT PEN—PRESS FIRMLY,
PRINT CLEARLY.

WATER WELL RECORD
KSA 82a-1201-1215

Kansas Department of Health and
Environment-Division of Environment
(Water well Contractors)
Topeka, Kansas 66620

1. Location of well:		County HARVEY	Fraction SE 1/4 SE 1/4 SW 1/4	Section number 30	Township number T 22 S	Range number R 1 E
2. Distance and direction from nearest town or city: 2 mi South +			3. Owner of well: Doug Stutzman			
Street address of well location if in city: 2 1/2 mi West - HESSTON			City, state, zip code: HESSTON, KANSAS 67062			
4. Locate with "X" in section below:		Sketch map:		6. Bore hole dia. 11 in. Completion date Well depth 55 ft. 3/29/78		
				7. <input checked="" type="checkbox"/> Cable tool <input checked="" type="checkbox"/> Rotary <input type="checkbox"/> Driven <input type="checkbox"/> Dug <input type="checkbox"/> Hollow rod <input type="checkbox"/> Jetted <input type="checkbox"/> Bored <input type="checkbox"/> Reverse rotary		
5. Type and color of material		From		To		8. Use: <input checked="" type="checkbox"/> Domestic <input type="checkbox"/> Public supply <input type="checkbox"/> Industry <input type="checkbox"/> Irrigation <input type="checkbox"/> Air conditioning <input type="checkbox"/> Stock <input type="checkbox"/> Lawn <input type="checkbox"/> Oil field water <input type="checkbox"/> Other
LOAM TO RED BROWN CLAY		1		5		9. Casing: Material PLASTIC Height: Above or below Threaded <input type="checkbox"/> Welded <input type="checkbox"/> Surface 12 in. RMP <input type="checkbox"/> PVC <input checked="" type="checkbox"/> Weight 2.76 lbs./ft. Dia. 5 in. to 55 ft. depth Wall Thickness: inches or Dia. <input type="checkbox"/> in. to <input type="checkbox"/> ft. depth Gauge No. 258
RED CLAY		5		13		10. Screen: Manufacturer's name Robin-Tech Type <input type="checkbox"/> Dia. 5" Slot/gauze .025 Length 10' Set between 34 ft. and 44 ft. ft. and <input type="checkbox"/> ft.
SANDY RED CLAY		13		15		Gravel pack? <input checked="" type="checkbox"/> Size range of material 48-fine
LIGHT BROWN CLAY		15		20		11. Static water level: <input type="checkbox"/> mo./day/yr. 21 ft. below land surface Date 3/16/78
GRIT - RED BROWN CLAY		20		27		12. Pumping level below land surfaces: 26 ft. after 2 hrs. pumping 20 g.p.m. <input type="checkbox"/> ft. after <input type="checkbox"/> hrs. pumping <input type="checkbox"/> g.p.m. Estimated maximum yield 40 g.p.m.
FINE SAND		27		32		13. Water sample submitted: <input type="checkbox"/> Yes <input checked="" type="checkbox"/> No Date <input type="checkbox"/>
COMPACTED EQUUS SAND - MED		32		40		14. Well head completion: <input checked="" type="checkbox"/> Pitless adapter <input type="checkbox"/> Inches above grade
COURSE - MED SAND		40		44		15. Well grouted? <input checked="" type="checkbox"/> With: <input checked="" type="checkbox"/> Neat cement <input type="checkbox"/> Bentonite <input type="checkbox"/> Concrete Depth: From 0 ft. to 12 ft.
LIGHT BROWN - GREY CLAY		44		48		16. Nearest source of possible contamination: ft. 105 Direction WEST Type SEWER Well disinfected upon completion? <input checked="" type="checkbox"/> Yes <input type="checkbox"/> No
" GREY TO WELLINGTON SHALE		48		55		17. Pump: <input type="checkbox"/> Not installed Manufacturer's name DEMETER Model number MBC-28-2 HP 1/2 Volts 245 Length of drop pipe 49 ft. capacity 12 g.p.m. Type: <input checked="" type="checkbox"/> Submersible <input type="checkbox"/> Turbine <input type="checkbox"/> Jet <input type="checkbox"/> Reciprocating <input type="checkbox"/> Centrifugal <input type="checkbox"/> Other
18. Elevation:		19. Remarks: " OLD WELL - filled + cemented off"				
Topography: <input type="checkbox"/> Hill <input type="checkbox"/> Slope <input type="checkbox"/> Upland <input type="checkbox"/> Valley		20. Water well contractor's certification: This well was drilled under my jurisdiction and this report is true to the best of my knowledge and belief. PAUL'S INC #175 Business name License No. Address HESSTON, KS Signed Paul Paulk Date 4/7/78 Authorized representative				