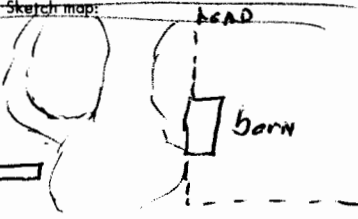
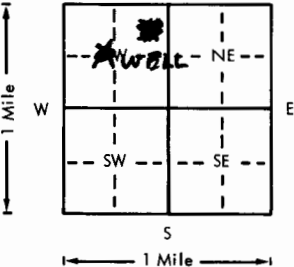


USE TYPEWRITER OR BALL
POINT PEN-PRESS FIRMLY,
PRINT CLEARLY.

WATER WELL RECORD
KSA 82a-1201-1215

Kansas Department of Health and
Environment-Division of Environment
(Water well Contractors)
Topeka, Kansas 66620

1. Location of well:	County HARVEY	Fraction SE 1/4 NW 1/4 NW 1/4	Section number 35	Township number T 22 S	Range number R 1 E
2. Distance and direction from nearest town or city: Street address of well location if in city:	2.50 Y 2 E of HESTON		3. Owner of well: HOWARD BECK R.R. or street: RR #1 City, state, zip code: HALSTEAD, KANSAS		
4. Locate with "X" in section below:	Sketch map: 		6. Bore hole dia. 14 in. Completion date Well depth 68 ft. 12-19-78		
	7. <input checked="" type="checkbox"/> Cable tool <input checked="" type="checkbox"/> Rotary <input type="checkbox"/> Driven <input type="checkbox"/> Dug <input type="checkbox"/> Hollow rod <input type="checkbox"/> Jetted <input type="checkbox"/> Bored <input type="checkbox"/> Reverse rotary		8. Use: <input checked="" type="checkbox"/> Domestic <input type="checkbox"/> Public supply <input type="checkbox"/> Industry <input type="checkbox"/> Irrigation <input type="checkbox"/> Air conditioning <input type="checkbox"/> Stock <input type="checkbox"/> Lawn <input type="checkbox"/> Oil field water <input type="checkbox"/> Other		
	9. Casing: Material PLASTIC Height Above or below Threaded <input type="checkbox"/> Welded <input type="checkbox"/> Surface 24 in. RMP <input type="checkbox"/> PVC <input checked="" type="checkbox"/> Weight 3.62 lbs./ft. Dia. 6 in. to 6.8 ft. depth Wall Thickness: inches or Dia. <input type="checkbox"/> in. to <input type="checkbox"/> ft. depth gage No. 280		10. Screen: Manufacturer's name Western - own slot Type PVC Dia. 6" Slot/gauze .046 Length 20' Set between 68 ft. and 48 ft. Gravel pack? <input checked="" type="checkbox"/> Size range of material 1/4"		
5. Type and color of material	From	To	11. Static water level: 10 ft. below land surface Date 12/19/78		
LOAM TO RED CLAY	0	5	12. Pumping level below land surfaces: 41 ft. after 2 hrs. pumping 14 g.p.m. ft. after <input type="checkbox"/> hrs. pumping <input type="checkbox"/> g.p.m. Estimated maximum yield 15/20 g.p.m.		
LIGHT BROWN CLAY	5	10	13. Water sample submitted: <input checked="" type="checkbox"/> Yes <input type="checkbox"/> No Date		
SANDY RED CLAY	10	12	14. Well head completion: <input checked="" type="checkbox"/> Pitless adapter <input type="checkbox"/> _____ Inches above grade		
RED CLAY	12	15	15. Well grouted? <input checked="" type="checkbox"/> With: <input checked="" type="checkbox"/> Neat cement <input type="checkbox"/> Bentonite <input type="checkbox"/> Concrete Depth: From 10 ft. to 0 ft.		
BROWN CLAY	15	20	16. Nearest source of possible contamination: BARN ft. 800 Direction North Type yard Well disinfected upon completion? <input checked="" type="checkbox"/> Yes <input type="checkbox"/> No		
LIGHT BROWN - SANDY CLAY	20	25	17. Pump: <input checked="" type="checkbox"/> Not installed Manufacturer's name _____ HP _____ Volts _____ Model number _____ Length of drop pipe _____ ft. capacity _____ g.p.m. Type: <input type="checkbox"/> Submersible <input type="checkbox"/> Turbine <input type="checkbox"/> Jet <input type="checkbox"/> Reciprocating <input type="checkbox"/> Centrifugal <input type="checkbox"/> Other		
FINE SAND	25	30	20. Water well contractor's certification: This well was drilled under my jurisdiction and this report is true to the best of my knowledge and belief. PAUL'S INC #175 Business name _____ License No. _____ Address Box 26 - Heston, KS Signed Paul Beul Date 1/30/78 Authorized representative		
GREEN GREY CLAY	30	35			
WHITE CLAY (ALKALI)	35	40			
CLAY WITH WHITE LIMESTONE	40	48			
SAND - MED COARSE	48	53			
GREEN SHALE	53	55			
" " TO WELLINGTON	55	60			
WELLINGTON - DARK SHALE	60	68			
(Use a second sheet if needed)					
18. Elevation:	19. Remarks:				
Topography: <input type="checkbox"/> Hill <input type="checkbox"/> Slope <input checked="" type="checkbox"/> Upland <input type="checkbox"/> Valley					