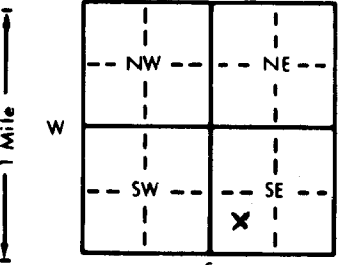


DW 3

WATER WELL RECORD

Form WWC-5

KSA 82a-1212

1 LOCATION OF WATER WELL:		Fraction	Section Number		Township Number		Range Number	
County: <u>Harvey</u>		<u>SW 1/4 SW 1/4 SE 1/4</u>	<u>9</u>		T <u>22</u> S		R <u>1</u> <u>EW</u>	
Distance and direction from nearest town or city street address of well if located within city? <u>Hay's Forage Facility Property</u>								
2 WATER WELL OWNER: <u>Hay's Forage Facility</u>								
RR#, St. Address, Box #: <u>420 W. Lincoln</u>								
City, State, ZIP Code: <u>Hepton KS 67062</u>								
Board of Agriculture, Division of Water Resources Application Number:								
3 LOCATE WELL'S LOCATION WITH AN "X" IN SECTION BOX:			4 DEPTH OF COMPLETED WELL: <u>39</u> ft. ELEVATION:					


What is the nearest source of possible contamination: 1 Septic tank 4 Lateral lines 7 Pit privy 10 Livestock pens 14 Abandoned water well 2 Sewer lines 5 Cess pool 8 Sewage lagoon 11 Fuel storage 15 Oil well/Gas well 3 Watertight sewer lines 6 Seepage pit 9 Feedyard 12 Fertilizer storage 16 Other (specify below) <u>Existing Voc Plumes</u> Direction from well? <u>N/A</u> How many feet? <u>0</u>								
FROM TO LITHOLOGIC LOG			FROM TO PLUGGING INTERVALS					
0 1 Top soil								
1 13.5 Gray - brn clay								
13.5 16 Fine sand								
16 34 Clay								
34 37 Sand								
37 39 Clay - shale								
7 CONTRACTOR'S OR LANDOWNER'S CERTIFICATION: This water well was (1) constructed, (2) reconstructed, or (3) plugged under my jurisdiction and was completed on (mo/day/year) <u>2/28/00</u> and this record is true to the best of my knowledge and belief. Kansas Water Well Contractor's License No. <u>581</u> This Water Well Record was completed on (mo/day/yr) <u>3-1-2000</u> under the business name of <u>Wayne Western a div of Wayne</u> by (signature) <u>Ken M. W. [Signature]</u>								
INSTRUCTIONS: Use typewriter or ball point pen. PLEASE PRESS FIRMLY and PRINT clearly. Please fill in blanks, underline or circle the correct answers. Send top three copies to Kansas Department of Health and Environment, Bureau of Water, Topeka, Kansas 66620-0001. Telephone: 913-296-5545. Send one to WATER WELL OWNER and retain one for your records.								