

| | | | | | |
|---------------------------|--|-----------------------------|----------------|-----------------|-------------------------|
| 1 LOCATION OF WATER WELL: | | Fraction | Section Number | Township Number | Range Number |
| County: <i>Harvey</i> | | <i>NW 1/4 SW 1/4 SW 1/4</i> | <i>10</i> | T <i>22</i> S | R <i>1</i> E <i>(W)</i> |

Distance and direction from nearest town or city street address of well if located within city?

509 Wedgewood Ct in Heston


| | |
|---|-------------------|
| 2 | WATER WELL OWNER: |
|---|-------------------|

Patric Moore
509 Wedgewood Ct
Hesston, KS 67062

Board of Agriculture, Division of Water Resources
Application Number:

3 LOCATE WELL'S LOCATION WITH AN "X" IN SECTION BOX:

4 DEPTH OF COMPLETED WELL 64 ft. ELEVATION:

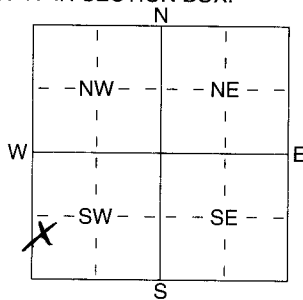

Depth(s) Groundwater Encountered 1 ft. 2 ft. 3 ft.
WELL'S STATIC WATER LEVEL 2.2 ft. below land surface measured on mo/day/yr 8-78-03 ft.
Pump test data: Well water was 6.0 ft. after 1 hours pumping 3.3 gpm
Est. Yield 3.5 gpm Well water was ft. after hours pumping gpm
WELL WATER TO BE USED AS: 5 Public water supply 8 Air conditioning 11 Injection well
1 Domestic 3 Feedlot 6 Oil field water supply 9 Dewatering 12 Other (Specify below)
2 Irrigation 4 Industrial 10 Domestic (lawn & garden) 10 Monitoring well

Was a chemical/bacteriological sample submitted to Department? Yes No X; If yes, mo/day/yr sample was submitted
Water Well Disinfected? Yes No

| | |
|---|----------------------------|
| 5 | TYPE OF BLANK CASING USED: |
|---|----------------------------|

5 Wrought iron
6 Asbestos-Cement
7 Fiberglass

8 Concrete tile
9 Other (specify below)

CASING JOINTS: Glued ☒ Clamped
Welded
Threaded

Blank casing diameter 6 in. to 25 ft., Dia in. to ft., Dia in. to ft.

Casing height above land surface 12 in., weight lbs./ft. Wall thickness or gauge No. 160.

TYPE OF SCREEN OR PERFORATION MATERIAL:

| | | |
|---------|--------------------|-----------------|
| 1 Steel | 3 Stainless Steel | 5 Fiberglass |
| 2 Brass | 4 Galvanized Steel | 6 Concrete tile |

⑦PVC

8 RMP (SR)
9 ABS

10 Asbestos-Cement
11 Other (Specify)
12 None used (open hole)

SCREEN OR PERFORATION OPENINGS ARE:

| | |
|--------------------|---------------|
| 1 Continuous slot | 3 Mill slot |
| 2 Louvered shutter | 4 Key punched |

5 Guazed wrapped
6 Wire wrapped
7 Torch cut

8 Saw cut
9 Drilled holes
10 Other (specify)
11 None (open hole)

SCREEN-PERFORATED INTERVALS: From 25 ft. to 34 ft. From _____ ft. to _____ ft.

GRAVEL PACK INTERVALS:

| | |
|---|-----------------|
| 6 | GROUT MATERIAL: |
|---|-----------------|

1 Neat cement

2 Cement grout

3 Bentonite

4 Other

Grout Intervals: From 2 ft. to 22 ft. From _____ ft. to _____ ft. From _____ ft. to _____ ft.

What is the nearest source of possible contamination:

- 1 Septic tank
- 2 Sewer lines
- 3 Watertight sewer lines
- 4 Lateral lines
- 5 Cess pool
- 6 Seepage pit

7 Pit privy
8 Sewage lagoon
9 Feedyard

| | |
|------------------------|--------------------------|
| 10 Livestock pens | 14 Abandoned water well |
| 11 Fuel storage | 15 Oil well/Gas well |
| 12 Fertilizer storage | 16 Other (specify below) |
| 13 Insecticide storage | |

Direction from well? 5

How many feet? 4.5

[illegible]

CONTRACTOR'S OR LANDOWNER'S CERTIFICATION: This water well was (1) constructed, (2) reconstructed, or (3) plugged under my jurisdiction and was completed on (mo/day/year) 8-18-03 and this record is true to the best of my knowledge and belief. Kansas Water Well Contractor's Licence No 447 This Water Well Record was completed on (mo/day/yr) 9-6-03 under the business name of Miller Drilling by (signature) [Signature]