


1 LOCATION OF WATER WELL: Fraction 5 1/2, SW 1/4 Section Number 16 Township Number 22S Range Number 1W EW

County: HARVEY

Distance and direction from nearest town or city street address of well if located within city?
APPROX. 0.5 MILE WEST OF HESSTON

2 WATER WELL OWNER: HARVEY COUNTY EXPERIMENT FIELD
 RR #, St. Address, Box #: 704 W. HICKORY Board of Agriculture, Division of Water Resources
 City, State, ZIP Code: HESSTON, KS 67062 Application Number:

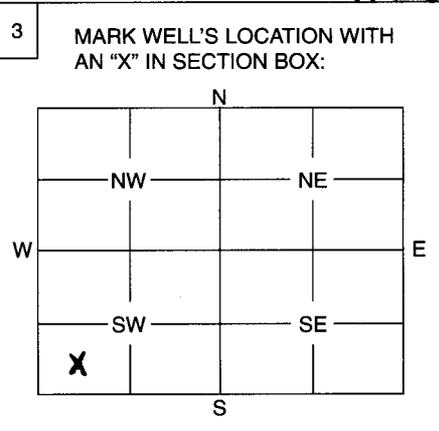

4 DEPTH OF WELL 25 ft.
 WELL'S STATIC WATER LEVEL 18 ft.

WELL WAS USED AS:

1 Domestic	5 Public Water Supply	9 Dewatering
2 Irrigation	6 Oil Field Water Supply	<u>10 Monitoring Well</u>
3 Feedlot	7 Domestic (Lawn & Garden)	11 Injection Well
4 Industrial	8 Air Conditioning	12 Other

Was a chemical / bacteriological sample submitted to Department? Yes No

If yes, mo/day/yr sample was submitted UNKNOWN.....

Water Well Disinfected: Yes No

OBSERVATION WELL OBY USGS REPORT 90-4019

5 TYPE OF BLANK CASING USED:

1 Steel	3 RMP (SR)	5 Wrought	7 Fiberglass	9 Other (Specify below)
<u>2 PVC</u>	4 ABS	6 Asbestos-Cement	8 Concrete Tile

Blank casing diameter 2.5 in. Was casing pulled? Yes No If yes, how much 25'

Casing height above or below land surface 18 in.

6 GROUT PLUG MATERIAL: 1 Neat cement 2 Cement grout 3 Bentonite 4 Other

Grout Plug Intervals: From 2.5 ft. to 1.5 ft., From ft. to ft., From to ft.

What is the nearest source of possible contamination:

1 Septic tank	6 Seepage pit	11 Fuel storage	16 Other (specify below)
2 Sewer lines	7 Pit privy	12 Fertilizer storage
3 <u>Watertight sewer lines</u>	8 Sewage lagoon	13 Insecticide storage	
4 <u>Lateral lines</u>	9 Feedyard	14 Abandoned water well	
5 Cess pool	10 Livestock pens	15 Oil well/Gas well	

Direction from well? N How many feet? 244

FROM	TO	PLUGGING MATERIALS
<u>25 FT</u>	<u>1.5 FT</u>	<u>HOLE PLUG - BENTONITE</u>

7 CONTRACTOR'S OF LANDOWNER'S CERTIFICATION: This water well was plugged under my jurisdiction and was completed on (mo/day/year) 12-12-02 and this record is true to the best of my knowledge and belief. Kansas Water Well Contractor's License No. This Water Well Record was completed on (mo/day/year) 12-16-03 under the business name of HARVEY COUNTY EXPERIMENT FIELD by (signature) Mark Claassen

INSTRUCTIONS: Use typewriter or ball point pen. Please press firmly and print clearly. Please fill in blanks, underline or circle the correct answers. Send top three copies to Kansas Department of Health and Environment, Bureau of Water, Geology Section, 1000 SW Jackson St., Ste. 420, Topeka, Kansas 66612-1367. Telephone: 785/296-5522. Send one to Water Well Owner and retain one for your records.