

CORRECTION(S) TO WATER WELL RECORD (WWC-5)

(to rectify lacking or incorrect information)

County: Harvey

Location listed as:

Location changed to:

Section-Township-Range: 34-225-1W

8-225-1W

Fraction ($\frac{1}{4}$ $\frac{1}{4}$ $\frac{1}{4}$): None Given

SW SW SE

Other changes: Initial statements: _____

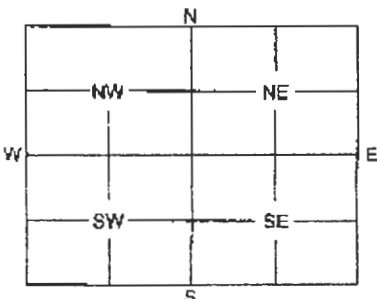
Changed to: _____

Comments: _____

verification method: Written description, well owner, aerial photo on KGS website, and Hesston 1:24,000 topo. map (city water facilities shown on map). initials: ORL date: 6/8/2005

submitted by: Kansas Geological Survey, Data Resources Library, 1930 Constant Ave., Lawrence, KS 66047-3726

to: Kansas Dept of Health & Environment, Bureau of Water, 1000 SW Jackson, Suite 420, Topeka, KS 66612-1367.

1	LOCATION OF WATER WELL:	Fraction	Section Number	Township Number	Range Number																								
	County: <u>Harvey</u>	$\frac{1}{4}$ $\frac{1}{4}$ $\frac{1}{4}$	<u>34</u>	<u>225</u>	<u>R 1</u> NW																								
Distance and direction from nearest town or city street address of well if located within city? <u>$\frac{3}{4}$ mile West of Hesston on Dutch Avenue</u>																													
2	WATER WELL OWNER: <u>City of Hesston</u> <u>P.O. Box 100 115 E. Smith</u> RR #, St. Address, Box #: City, State, ZIP Code: <u>Hesston, KS. 67062</u>																												
Board of Agriculture, Division of Water Resources Application Number:																													
3	MARK WELL'S LOCATION WITH AN "X" IN SECTION BOX:																												
		4 DEPTH OF WELL <u>22</u> ft. WELL'S STATIC WATER LEVEL <u>10</u> ft. WELL WAS USED AS: 1 Domestic 5 Public Water Supply 9 Dewatering 2 Irrigation 6 Oil Field Water Supply 10 Monitoring Well 3 Feedlot 7 Domestic (Lawn & Garden) 11 Injection Well 4 Industrial 8 Air Conditioning 12 Other Was a chemical / bacteriological sample submitted to Department? Yes _____ No <u>X</u> If yes, mo/day/yr sample was submitted _____ Water Well Disinfected: Yes <u>X</u> No _____																											
5	TYPE OF BLANK CASING USED:																												
1 Steel 3 RMP (SR) 5 Wrought 7 Fiberglass 9 Other (Specify below) 2 PVC 4 ABS 6 Asbestos-Cement 8 Concrete Tile																													
Blank casing diameter <u>6</u> in. Was casing pulled? Yes <u>X</u> No <u>X</u> If yes, how much <u>2 1/2</u> ft. Casing height above or below land surface _____ in.																													
6	GROUT PLUG MATERIAL: 1 Neat cement 2 Cement grout 3 Bentonite 4 Other _____																												
Grout Plug Intervals: From _____ ft. to _____ ft., From <u>12</u> ft. to <u>2</u> ft., From _____ ft. to _____ ft.																													
What is the nearest source of possible contamination:																													
1 Septic tank 8 Seepage pit 11 Fuel storage 16 Other (specify below) 2 Sewer lines 7 Pit privy 12 Fertilizer storage 3 Watertight sewer lines 9 Sewage lagoon 13 Insecticide storage 4 Lateral lines 10 Feedyard 14 Abandoned water well 5 Cess pool 10 Livestock pens 15 Oil well/Gas well																													
Direction from well? _____ How many feet? _____																													
<table border="1" style="width:100%; border-collapse: collapse;"> <thead> <tr> <th style="width:15%;">FROM</th> <th style="width:15%;">TO</th> <th style="width:70%;">PLUGGING MATERIALS</th> </tr> </thead> <tbody> <tr> <td><u>22'</u></td> <td><u>12'</u></td> <td><u>Coarse Sand chlorinated</u></td> </tr> <tr> <td><u>12'</u></td> <td><u>2'</u></td> <td><u>Bentonite chips</u></td> </tr> <tr> <td><u>2'</u></td> <td><u>0'</u></td> <td><u>clay soil</u></td> </tr> <tr> <td></td> <td></td> <td><u>8' x 10' concrete pad</u></td> </tr> <tr><td> </td><td> </td><td> </td></tr> <tr><td> </td><td> </td><td> </td></tr> <tr><td> </td><td> </td><td> </td></tr>
7	CONTRACTOR'S OF LANDOWNER'S CERTIFICATION: This water well was <u>plugged</u> under my jurisdiction and was completed on (mo/day/year) <u>May 17, 2005</u> and this record is true to the best of my knowledge and belief. Kansas Water Well Contractor's License No. <u>671105</u> This Water Well Record was completed on (mo/day/year) <u>6/1/05</u> under the business name of <u>City of Hesston</u> by (signature) <u>Kendall Schwonke</u> Parks Supt.																												
INSTRUCTIONS: Use typewriter or ball point pen. Please press firmly and print clearly. Please fill in blanks, underline or circle the correct answers. Send top three copies to Kansas Department of Health and Environment, Bureau of Water, Geology Section, 1000 SW Jackson St., Ste. 420, Topeka, Kansas 66612-1367. Telephone: 785/296-5522. Send one to Water Well Owner and retain one for your records.																													