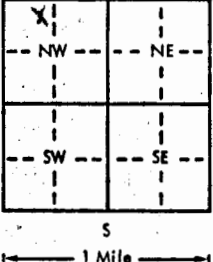
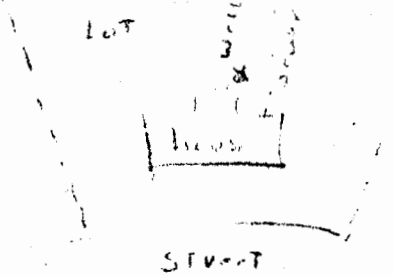


Best Available Copy

USE TYPEWRITER OR BALL
POINT PEN-PRESS FIRMLY,
PRINT CLEARLY.

WATER WELL RECORD
KSA 82a-1201-1215

Kansas Department of Health and
Environment-Division of Environment
(Water well Contractors)
Topeka, Kansas 66620

1. Location of well:		County HARVEY	Fraction NE 1/4 NW 1/4 NW 1/4	Section number 5	Township number T 22 S	Range number R 1 E/W
2. Distance and direction from nearest town or city: Street address of well location if in city: Same			3. Owner of well: ERNEST HEIDE BRECHT R.R. or street: 112 MEADOW LANE City, state, zip code: NESTON KANS 67617			
4. Locate with "X" in section below: 			Sketch map: 		6. Bore hole dia. 12 in. Completion date 6/17/76 Well depth 48 ft.	
					7. <input checked="" type="checkbox"/> Cable tool <input checked="" type="checkbox"/> Rotary <input type="checkbox"/> Driven <input type="checkbox"/> Dug <input type="checkbox"/> Hollow rod <input type="checkbox"/> Jetted <input type="checkbox"/> Bored <input type="checkbox"/> Reverse rotary	
					8. Use: <input type="checkbox"/> Domestic <input type="checkbox"/> Public supply <input type="checkbox"/> Industry <input type="checkbox"/> Irrigation <input type="checkbox"/> Air conditioning <input type="checkbox"/> Stock <input checked="" type="checkbox"/> Lawn <input type="checkbox"/> Oil field water <input type="checkbox"/> Other	
					9. Casing: Material Steel Height: Above or below Threaded <input type="checkbox"/> Welded <input checked="" type="checkbox"/> Surface 12 in. RMP PVC Weight 3.23 lbs./ft. Dia. 4 in. to 40 ft. depth Wall Thickness: inches or Dia. 1 in. to 40 ft. depth gage No. 255	
5. Type and color of material			From	To	10. Screen: Manufacturer's name Sabco Type Dug Dia. 6 in. Slot/gauze 0.64 Length 10 ft. Set between 28 ft. and 38 ft. Gravel pack? Yes Size range of material 1/2 - 1/4	
Top Layer			0	3	11. Static water level: 15 ft. below land surface Date 6/17/76	
Brown clay			3	8	12. Pumping level below land surfaces: 38 ft. after 1 hrs. pumping 18 g.p.m. ft. after 1 hrs. pumping 18 g.p.m. Estimated maximum yield 18 g.p.m.	
Alkali clay			8	18	13. Water sample submitted: Yes <input checked="" type="checkbox"/> No <input type="checkbox"/> Date 6/17/76	
Brown clay			18	25	14. Well head completion: <input type="checkbox"/> Pitless adapter 12 inches above grade	
Small to med. sand			25	34	15. Well grouted? Yes With: <input checked="" type="checkbox"/> Neat cement <input type="checkbox"/> Bentonite <input type="checkbox"/> Concrete Depth: From 0 ft. to 10 ft.	
Green-gray to blue shale			34	38	16. Nearest source of possible contamination: house ft. 24 Direction South Type house Well disinfected upon completion? Yes <input checked="" type="checkbox"/> No <input type="checkbox"/>	
Brown shale to blue			38	40	17. Pump: <input type="checkbox"/> Not installed Manufacturer's name VALLEY Model number S-1487-FHP 1/2 Volts 230 Length of drop pipe 40 ft. capacity 18 g.p.m. Type: <input checked="" type="checkbox"/> Submersible <input type="checkbox"/> Turbine <input type="checkbox"/> Jet <input type="checkbox"/> Reciprocating <input type="checkbox"/> Centrifugal <input type="checkbox"/> Other	
(Use a second sheet if needed)					20. Water well contractor's certification: This well was drilled under my jurisdiction and this report is true to the best of my knowledge and belief. PAULS INC #175 Business name HESTON KANS License No. Address 112 Meadow Lane Signed Paul Brecht Date 6/17/76 Authorized representative	
18. Elevation:		19. Remarks:		20. Water well contractor's certification:		
Topography: <input type="checkbox"/> Hill <input type="checkbox"/> Slope <input type="checkbox"/> Upland <input type="checkbox"/> Valley						

Forward the white, blue and pink copies to the Department of Health and Environment

Form WWC-5