

2511128

mw-10

WATER WELL RECORD

Form WWC-5

KSA 82a-1212


1 LOCATION OF WATER WELL:	Fraction	Section Number	Township Number	Range Number
County: <u>Harvey</u>	<u>NE 1/4 SE 1/4 SE 1/4</u>	<u>26</u>	<u>T 22 S</u>	<u>R 1 E</u>

Distance and direction from nearest town or city street address of well if located within city?

33'SW, 50'N of NW corner of house

2 WATER WELL OWNER: <u>Daisy Nebergall</u>	Board of Agriculture, Division of Water Resources
RR#, St. Address, Box #: <u>1210 S. Poplar</u>	Application Number:
City, State, ZIP Code: <u>Newton, KS 67114</u>	

3 LOCATE WELL'S LOCATION WITH AN "X" IN SECTION BOX:	4 DEPTH OF COMPLETED WELL: <u>20.0</u> ft. ELEVATION: <u>1472.59 TOC</u>
--	--

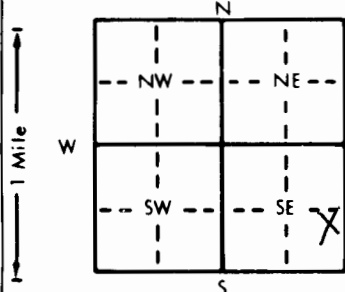

Depth(s) Groundwater Encountered	1. ft.	2. ft.	3. ft.
WELL'S STATIC WATER LEVEL	<u>16.61</u> ft. below land surface measured on mo/day/yr	<u>2/4/98</u>	
Pump test data:	Well water was	ft. after	hours pumping
Est. Yield	gpm	Well water was	ft. after
Bore Hole Diameter	<u>8</u> in. to	<u>20.0</u> ft. and	in. to
WELL WATER TO BE USED AS:	5 Public water supply	8 Air conditioning	11 Injection well
1 Domestic	3 Feedlot	6 Oil field water supply	9 Dewatering
2 Irrigation	4 Industrial	7 Lawn and garden only	10 <u>Monitoring well</u>
Was a chemical/bacteriological sample submitted to Department? Yes..... No..... <u>X</u> . If yes, mo/day/yr sample was submitted			
Water Well Disinfected? Yes..... No..... <u>X</u>			

5 TYPE OF BLANK CASING USED:	5 Wrought iron	8 Concrete tile	CASING JOINTS: Glued..... Clamped.....
1 Steel	3 RMP (SR)	6 Asbestos-Cement	9 Other (specify below)
2 PVC	4 ABS	7 Fiberglass	
Blank casing diameter	<u>2</u> in. to	<u>10</u> ft. Dia	in. to
Casing height above land surface	<u>flush</u> in., weight	<u>0.703</u> lbs./ft.	Wall thickness or gauge No. <u>Sch 40</u>

TYPE OF SCREEN OR PERFORATION MATERIAL:	10 Asbestos-cement
1 Steel	3 Stainless steel
2 Brass	4 Galvanized steel
5 Fiberglass	8 RMP (SR)
6 Concrete tile	9 ABS
11 Other (specify)	12 None used (open hole)

SCREEN OR PERFORATION OPENINGS ARE:	5 Gauzed wrapped	8 Saw cut	11 None (open hole)
1 Continuous slot	6 Wire wrapped	9 Drilled holes	
2 Louvered shutter	7 Torch cut	10 Other (specify)	
4 Key punched			

SCREEN-PERFORATED INTERVALS:	From	<u>10</u> ft. to	<u>20</u> ft.	From	ft. to	ft.
GRAVEL PACK INTERVALS:	From	<u>8</u> ft. to	<u>20</u> ft.	From	ft. to	ft.

6 GROUT MATERIAL:	1 Neat cement	2 Cement grout	3 <u>Bentonite</u>	4 Other		
Grout Intervals:	From	<u>1</u> ft. to	<u>8</u> ft.	From	ft. to	ft.

What is the nearest source of possible contamination:	10 Livestock pens	14 Abandoned water well
1 Septic tank	11 Fuel storage	15 Oil well/Gas well
2 Sewer lines	12 Fertilizer storage	16 Other (specify below)
3 Watertight sewer lines	13 Insecticide storage	
4 Lateral lines		
5 Cess pool		
6 Seepage pit		
7 Pit privy		
8 Sewage lagoon		
9 Feedyard		

Direction from well?	How many feet?
----------------------	----------------

FROM	TO	LITHOLOGIC LOG	FROM	TO	PLUGGING INTERVALS
<u>0</u>	<u>1.5</u>	<u>Topsoil/Fill</u>			
<u>1.5</u>	<u>5</u>	<u>Clay, h-m plasticity</u>			
<u>5</u>	<u>20</u>	<u>Sandy clay, v-f grained</u>			

7 CONTRACTOR'S OR LANDOWNER'S CERTIFICATION: This water well was <u>(1) constructed</u> , (2) reconstructed, or (3) plugged under my jurisdiction and was completed on (mo/day/year) <u>2/27/98</u> and this record is true to the best of my knowledge and belief. Kansas Water Well Contractor's License No. <u>531</u> This Water Well Record was completed on (mo/day/yr) <u>3/27/98</u> under the business name of <u>GSI</u> by (signature) <u>Candace Watson</u>
