

# WATER WELL PLUGGING RECORD Form WWC-5P

KSA 82a-1212

ID NO.

MW4

<b>1 LOCATION OF WATER WELL:</b> County: HARVEY	Fraction SE ¼ SW ¼ NE ¼ ¼	Section Number 16	Township Number T 22 S	Range Number 1 <input type="checkbox"/> E <input checked="" type="checkbox"/> W
--	------------------------------	----------------------	---------------------------	--

Street/Rural Address of Well Location; if unknown, distance & direction from nearest town or intersection: If at owner's address, check here ☒


## Global Positioning Systems (GPS) information:

Latitude: 38.1383784 (in decimal degrees)  
Longitude: -97.4323512 (in decimal degrees)  
Elevation: 1480.69  
Horizontal Datum: ☐ WGS84, ☒ NAD83, ☐ NAD27  
Collection Method:

**2 WATER WELL OWNER:** MARLIN HEIBERT  
RR#, St. Address, Box #: 112 OLD HWY 81  
City, State ZIP Code: HESSTON, KS 67062

☐ GPS unit (Make/Model: \_\_\_\_\_)  
☐ Digital Map/Photo, ☐ Topographic Map, ☒ Land Survey  
Est. Accuracy: ☒ < 3 m, ☐ 3-5 m, ☐ 5-15 m, ☐ > 15 m

## 3 MARK WELL'S LOCATION WITH AN "X" IN SECTION BOX:

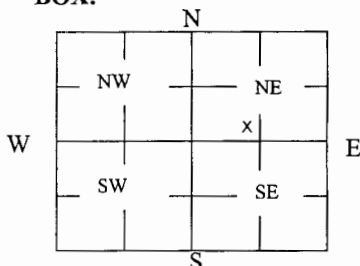

## 4 DEPTH OF WELL 20.72 ft.

WELL'S STATIC WATER LEVEL 19.34 ft

### WELL WAS USED AS:

- |                                     |   |  |
|-------------------------------------|---|--|
| <input type="checkbox"/> Domestic   | <input type="checkbox"/> Public Water Supply      | <input type="checkbox"/> Dewatering            |
| <input type="checkbox"/> Irrigation | <input type="checkbox"/> Oil Field Water Supply   | <input checked="" type="checkbox"/> Monitoring |
| <input type="checkbox"/> Feedlot    | <input type="checkbox"/> Domestic (Lawn & Garden) | <input type="checkbox"/> Injection Well        |
| <input type="checkbox"/> Industrial | <input type="checkbox"/> Air Conditioning         | <input type="checkbox"/> Other _____           |

Was a chemical/bacteriological sample submitted to Department? Yes ☐ No ☒

## 5 TYPE OF BLANK CASING USED:

- ☐ Steel ☐ RMP (SR) ☐ Wrought ☐ Fiberglass ☐ Other (Specify below)  
☒ PVC ☐ ABS ☐ Asbestos-Cement ☐ Concrete Tile

Blank casing diameter 2 in. Was casing pulled? Yes ☒ No ☐ If yes, how much 3'  
Casing height above or below land surface 0 in.

## 6 GROUT PLUG MATERIAL: ☐ Neat cement ☐ Cement grout ☒ Bentonite ☒ Other GRAVEL

Grout Plug Intervals: From 0 ft. to .5 ft., From .5 ft. to 20.72 ft., From \_\_\_\_\_ ft. to \_\_\_\_\_ ft.

What is the nearest source of possible contamination:

- |   |   |  |  |
|---|---|--|--|
| <input type="checkbox"/> Septic tank            | <input type="checkbox"/> Seepage pit    | <input checked="" type="checkbox"/> Fuel storage | <input type="checkbox"/> Other (specify below) |
| <input type="checkbox"/> Sewer lines            | <input type="checkbox"/> Pit privy      | <input type="checkbox"/> Fertilizer storage      |  |
| <input type="checkbox"/> Watertight sewer lines | <input type="checkbox"/> Sewage lagoon  | <input type="checkbox"/> Insecticide storage     |  |
| <input type="checkbox"/> Lateral lines          | <input type="checkbox"/> Feedyard       | <input type="checkbox"/> Abandoned water well    | Direction from well? _____                     |
| <input type="checkbox"/> Cess pool              | <input type="checkbox"/> Livestock pens | <input type="checkbox"/> Oil well/Gas well       | How many feet? _____                           |

FROM	TO	PLUGGING MATERIALS	FROM	TO	PLUGGING MATERIALS
0	.5	GRAVEL			
.5	20.72	BENTONITE			

**7 CONTRACTOR'S OR LANDOWNER'S CERTIFICATION:** This water well was plugged under my jurisdiction and was completed on (mo/day/year) 2/15/18 and this record is true to the best of my knowledge and belief. Kansas Water Well Contractor's License No. 585. This Water Well Record was completed on (mo/day/year) 2/26/18 under the business name of ASSOCIATED ENVIRONMENTAL INC by (signature) *[Signature]*


Send one white copy to Kansas Department of Health & Environment, Geology Section, 1000 SW Jackson Street, Ste. 420, Topeka, KS 66612-1367. Send one copy to WATER WELL OWNER and retain one for your records.

Visit us at <http://www.kdheks.gov/waterwell/index.html> Telephone 785-296-5524.

KSA82a-1212

Revised 1/20/2015

Harveyco S16 225 1W

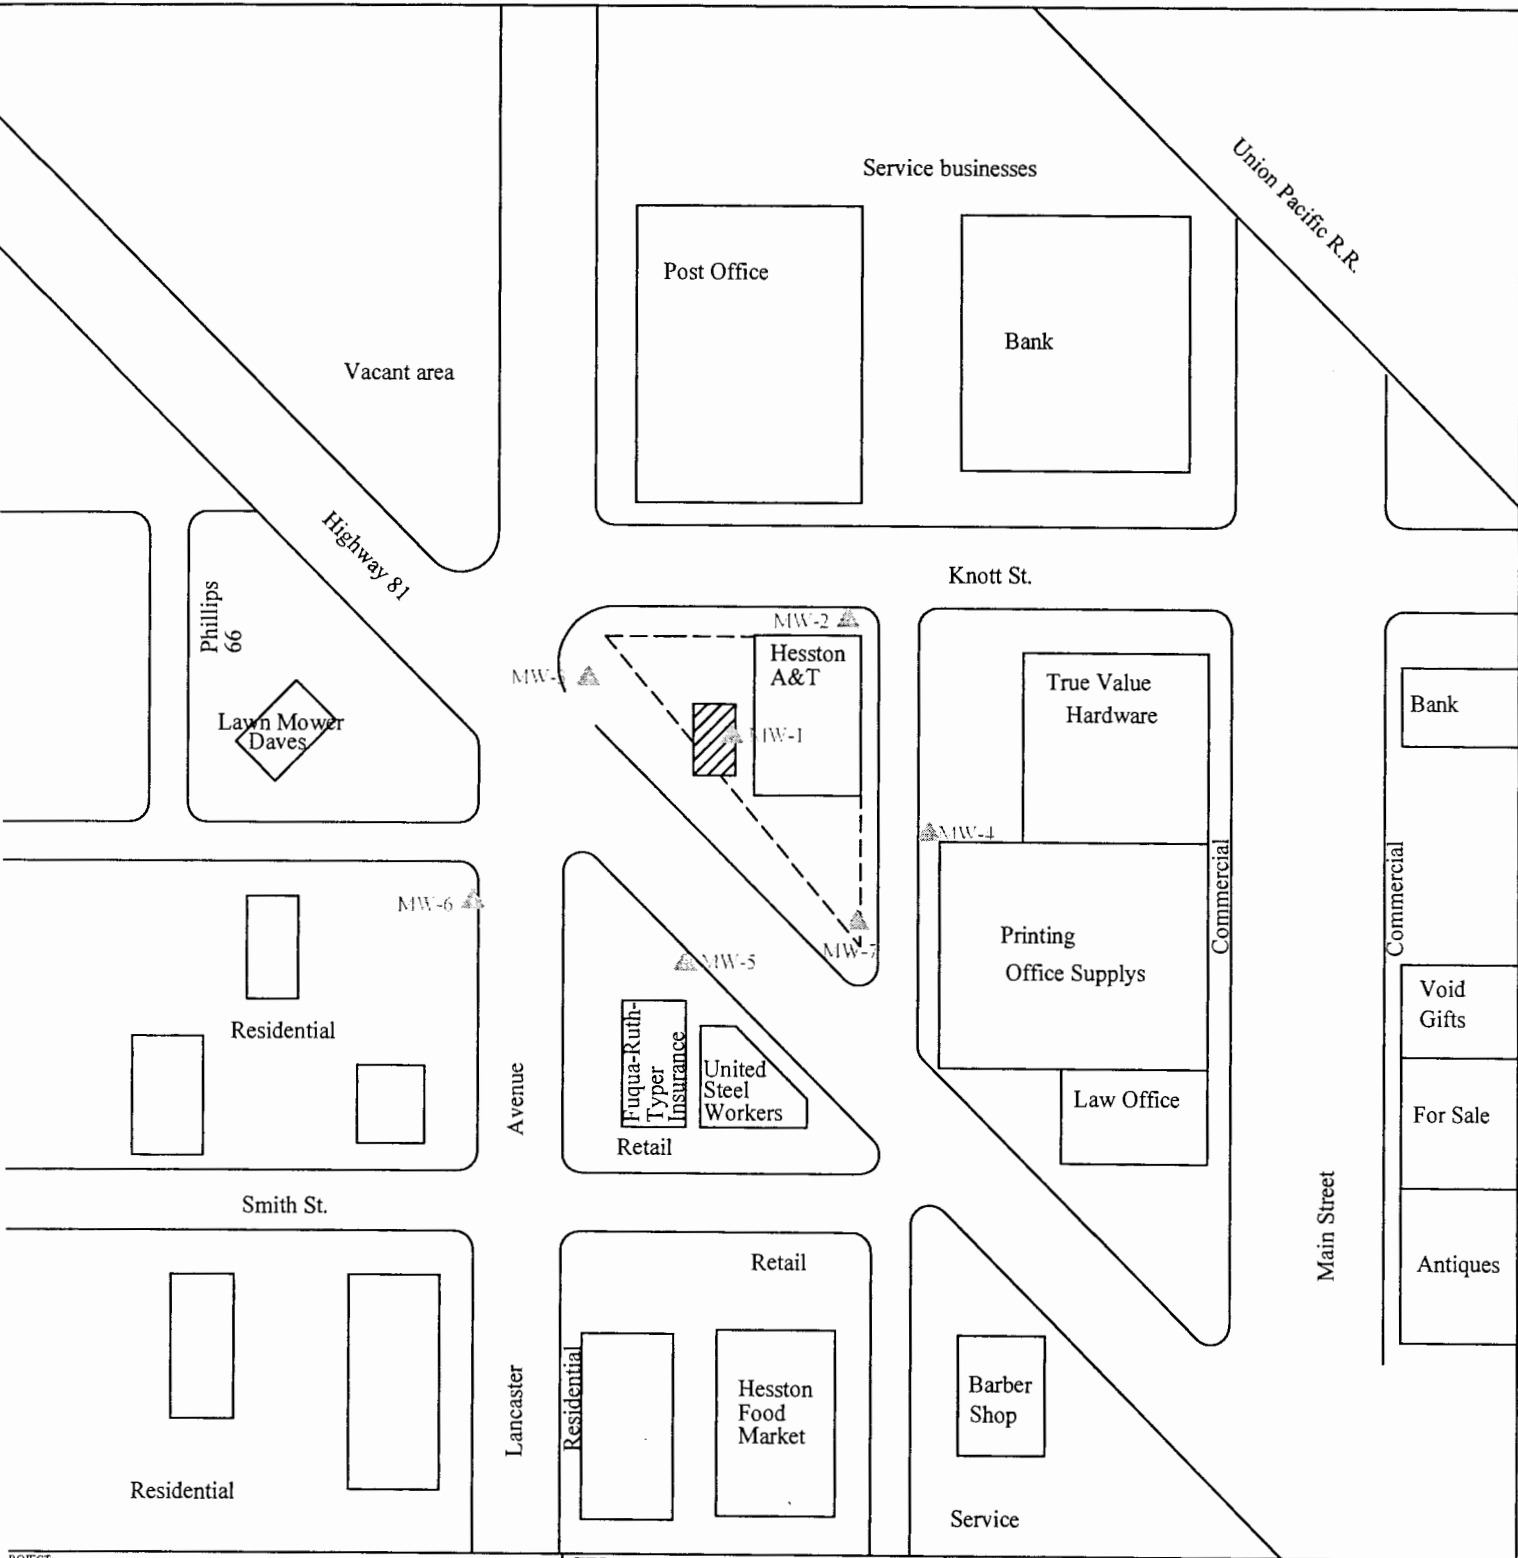

PROJECT: **Hesston Auto & Truck**

ADDRESS: **112 Old Hwy 81**

LOCATION: **Hesston, KS**

DRAWN BY: **DD** DATE: **02/05/94**

REVISED BY: **B. STALNAKER** DATE: **2/26/18**

EI JOB #: **TF119** KDH/E JOB #: **U2 040 193**

SCALE: **1"=100'**

NOTES: **Date Sampled: 10/31/16**

TITLE:

**AE** ASSOCIATED ENVIRONMENTAL INC.

LEGEND:

- = Former pump island/UST location: 2-2,000 gallon gasoline
- = New Monitoring Well Locations
- = PLUGGED/DESTROYED WELL
- = Property Boundary