

WATER WELL PLUGGING RECORD Form WWC-5P

KSA 82a-1212

ID NO.

MW5

1 LOCATION OF WATER WELL: County: HARVEY	Fraction SE 1/4 SW 1/4 NE 1/4 1/4	Section Number 16	Township Number T 22 S	Range Number 1 <input type="checkbox"/> E <input checked="" type="checkbox"/> W
--	--------------------------------------	----------------------	---------------------------	--

Street/Rural Address of Well Location; if unknown, distance & direction from nearest town or intersection: If at owner's address, check here ☒


Global Positioning Systems (GPS) information:

Latitude: 38.1383784 (in decimal degrees)
Longitude: -97.4323512 (in decimal degrees)
Elevation: 1480.18
Horizontal Datum: ☐ WGS84, ☒ NAD83, ☐ NAD27
Collection Method:

2 WATER WELL OWNER: MARLIN HEIBERT
RR#, St. Address, Box #: 112 OLD HWY 81
City, State ZIP Code: HESSTON, KS 67062

☐ GPS unit (Make/Model: _____)
☐ Digital Map/Photo, ☐ Topographic Map, ☒ Land Survey
Est. Accuracy: ☒ < 3 m, ☐ 3-5 m, ☐ 5-15 m, ☐ > 15 m

3 MARK WELL'S LOCATION WITH AN "X" IN SECTION BOX:

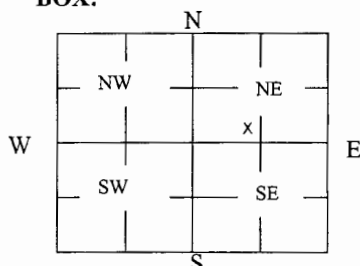

4 DEPTH OF WELL 20.54 ft.

WELL'S STATIC WATER LEVEL 19.23 ft

WELL WAS USED AS:

☐ Domestic ☐ Public Water Supply ☒ Dewatering
☐ Irrigation ☐ Oil Field Water Supply ☐ Monitoring
☐ Feedlot ☐ Domestic (Lawn & Garden) ☐ Injection Well
☐ Industrial ☐ Air Conditioning ☐ Other _____

Was a chemical/bacteriological sample submitted to Department? Yes ☐ No ☒

5 TYPE OF BLANK CASING USED:

☐ Steel ☐ RMP (SR) ☐ Wrought ☐ Fiberglass ☐ Other (Specify below)
☒ PVC ☐ ABS ☐ Asbestos-Cement ☐ Concrete Tile

Blank casing diameter 2 in. Was casing pulled? Yes ☒ No ☐ If yes, how much 3'
Casing height above or below land surface 0 in.

6 GROUT PLUG MATERIAL: ☐ Neat cement ☐ Cement grout ☒ Bentonite ☒ Other SOIL

Grout Plug Intervals: From 0 ft. to .5 ft., From .5 ft. to 20.54 ft., From _____ ft. to _____ ft.

What is the nearest source of possible contamination:

☐ Septic tank ☐ Seepage pit ☒ Fuel storage ☐ Other (specify below)
☐ Sewer lines ☐ Pit privy ☐ Fertilizer storage
☐ Watertight sewer lines ☐ Sewage lagoon ☐ Insecticide storage
☐ Lateral lines ☐ Feedyard ☐ Abandoned water well
☐ Cess pool ☐ Livestock pens ☐ Oil well/Gas well
Direction from well? _____
How many feet? _____

FROM	TO	PLUGGING MATERIALS	FROM	TO	PLUGGING MATERIALS
0	.5	SOIL			
.5	20.54	BENTONITE			

7 CONTRACTOR'S OR LANDOWNER'S CERTIFICATION: This water well was plugged under my jurisdiction and was completed on (mo/day/year) 2/15/18 and this record is true to the best of my knowledge and belief. Kansas Water Well Contractor's License No. 585. This Water Well Record was completed on (mo/day/year) 2/26/18 under the business name of ASSOCIATED ENVIRONMENTAL INC by (signature) *Charles Johnson*


Send one white copy to Kansas Department of Health & Environment, Geology Section, 1000 SW Jackson Street, Ste. 420, Topeka, KS 66612-1367. Send one copy to WATER WELL OWNER and retain one for your records.

Visit us at <http://www.kdheks.gov/waterwell/index.html> Telephone 785-296-5524.

KSA82a-1212

Revised 1/20/2015

Harveyco S16 225 1W

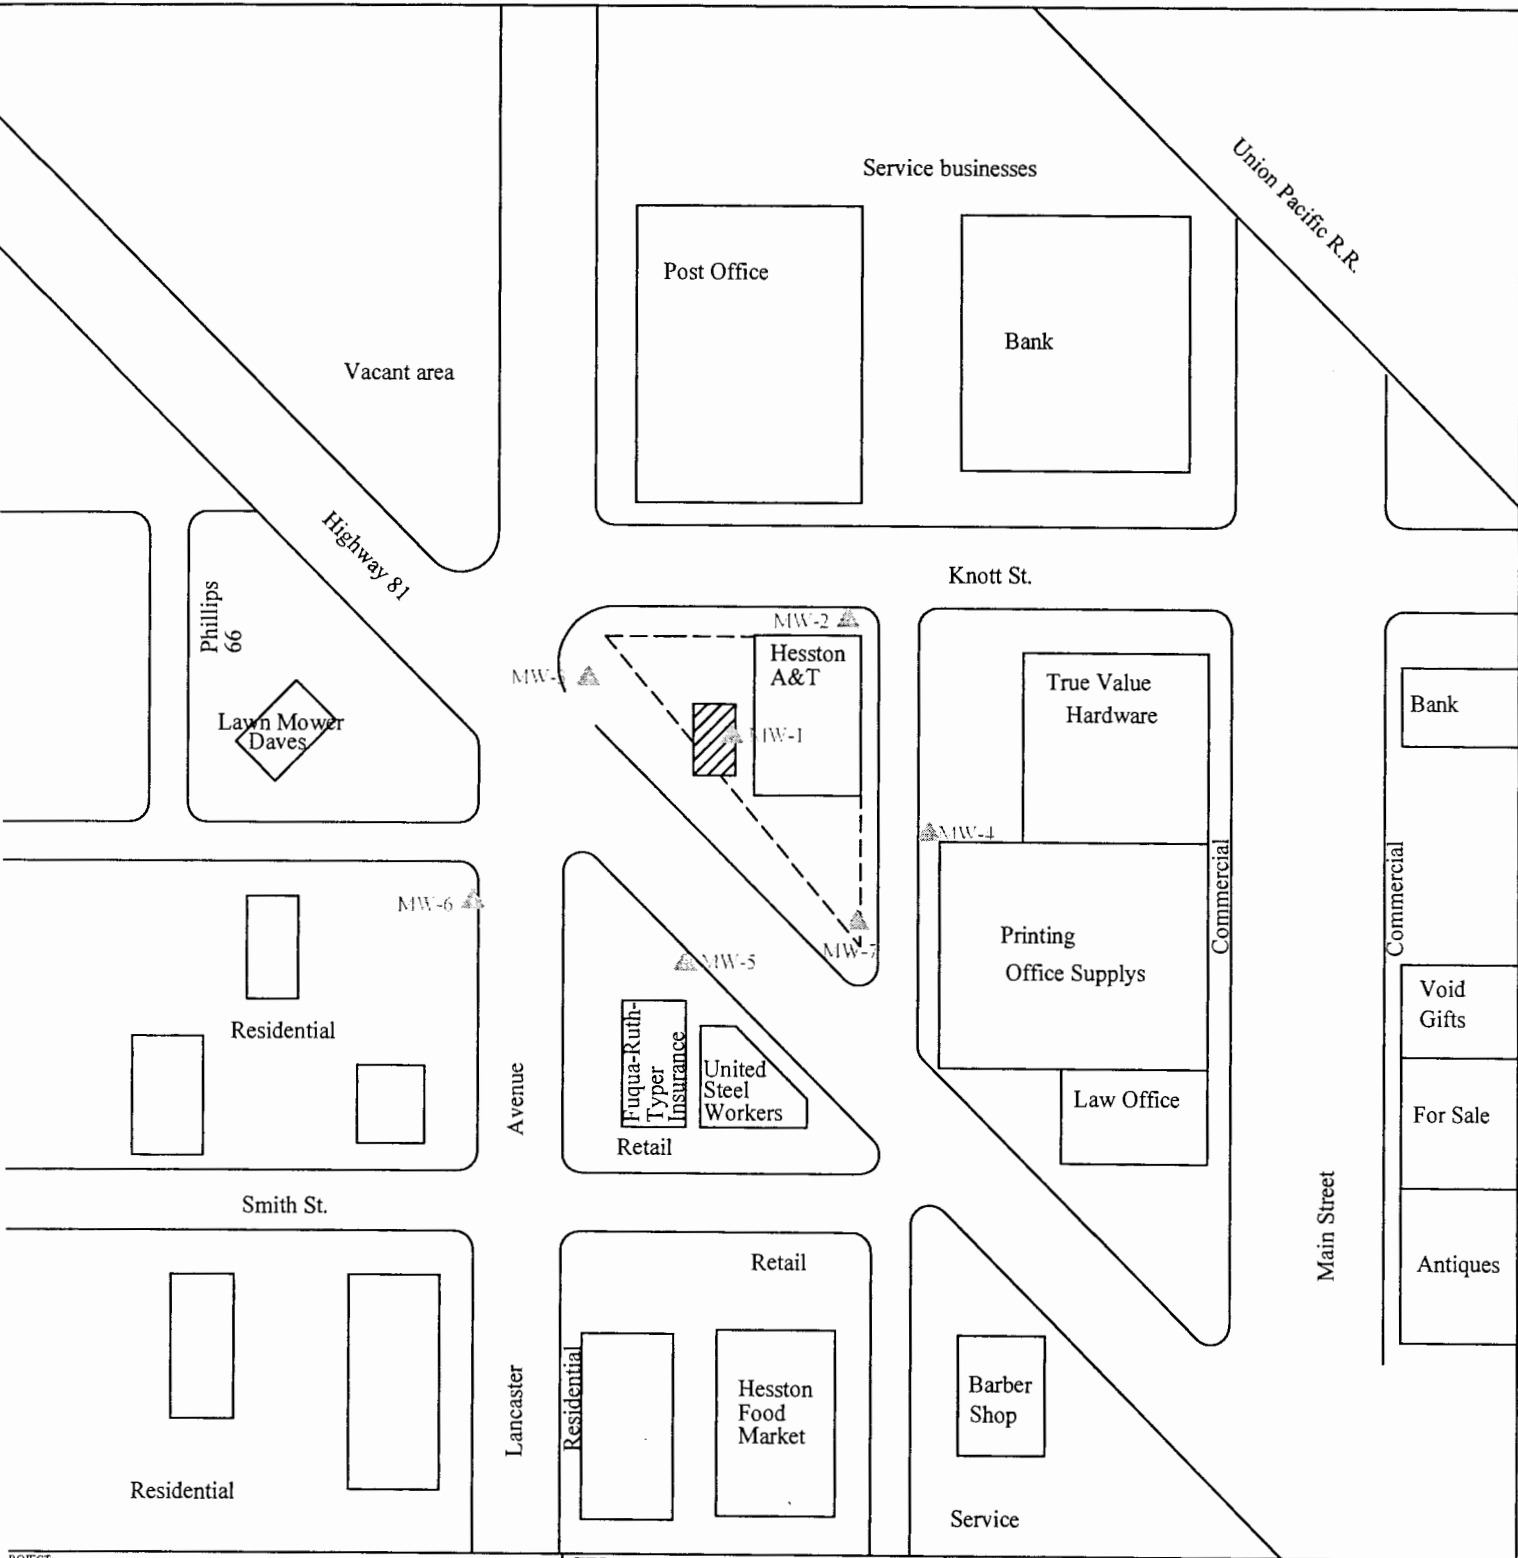

PROJECT: **Hesston Auto & Truck**

ADDRESS: **112 Old Hwy 81**

LOCATION: **Hesston, KS**

DRAWN BY: **DD** DATE: **02/05/94**

REVISED BY: **B. STALNAKER** DATE: **2/26/18**

EI JOB #: **TF119** KDHE JOB #: **U2 040 193**

SCALE: **1"=100'**

NOTES: **Date Sampled: 10/31/16**

TITLE:

AE ASSOCIATED ENVIRONMENTAL INC.

LEGEND:

- = Former pump island/UST location: 2-2,000 gallon gasoline
- = New Monitoring Well Locations
- = PLUGGED/DESTROYED WELL
- = Property Boundary