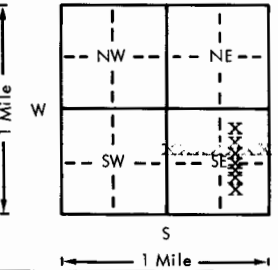


USE TYPEWRITER OR BALL
POINT PEN-PRESS FIRMLY,
PRINT CLEARLY.

WATER WELL RECORD
KSA 82a-1201-1215

Kansas Department of Health and
Environment-Division of Environment
(Water well Contractors)
Topeka, Kansas 66620

PAGE -1-


1. Location of well:		County Reno	Fraction E 1/2 1/4 SE 1/4	Section number 5	Township number T 22 S R 10	Range number EW
2. Distance and direction from nearest town or city: 18 miles West of Nickerson, KS Street address of well location if in city:				3. Owner of well: Dean Anthony R.R. or street: (?) City, state, zip code: Iuka, KS 67066		
4. Locate with "X" in section below:		Sketch map: NOTE: This is a manifold system consisting of 7 42' wells 50' apart. Casing & screen are set in the same place in all 7 wells. Well No. 1 is the South Well. No. 4 well is Approximately 20' East of Pivot.		6. Bore hole dia. 24 in. Completion date 8-22-8-23 8-24-77 Well depth 42 ft. each well		
				7. <input type="checkbox"/> Cable tool <input type="checkbox"/> Rotary <input type="checkbox"/> Driven <input type="checkbox"/> Dug <input type="checkbox"/> Hollow rod <input type="checkbox"/> Jetted <input type="checkbox"/> Bored <input checked="" type="checkbox"/> Reverse rotary		
5. Type and color of material		From		To		8. Use: <input type="checkbox"/> Domestic <input type="checkbox"/> Public supply <input type="checkbox"/> Industry <input checked="" type="checkbox"/> Irrigation <input type="checkbox"/> Air conditioning <input type="checkbox"/> Stock <input type="checkbox"/> Lawn <input type="checkbox"/> Oil field water <input type="checkbox"/> Other
Well #1 Sand, sandy top soil & clay streak at 28' & 32'		0		33		9. Casing: Material steel Height: Above or below Threaded <input type="checkbox"/> Welded <input checked="" type="checkbox"/> Surface 12 in. RMP <input type="checkbox"/> PVC <input type="checkbox"/> Weight 30.3 lbs./ft. Dia. 16 in. to 34 ft. depth Wall Thickness: inches or Dia. <input type="checkbox"/> in. to <input type="checkbox"/> ft. depth gage No. 7 ga.
Good sand & gravel		33		42		10. Screen: Manufacturer's name W. A. Brown Type Double-slot Dia. 16" Slot/gauze 1/8 Length 8' Set between 34' ft. and 42' ft. ft. and <input type="checkbox"/> ft.
Well #2 Top soil & fine sand		0		16		Gravel pack? yes Size range of material 3/8-260
Gray clay & clay streak at 22' & 30'		17		33		11. Static water level: 13' 1" ft. below land surface Date 8-22-8-23/8-24-77
Good gravel		33		42		12. Pumping level below land surfaces: ft. after <input type="checkbox"/> hrs. pumping <input type="checkbox"/> g.p.m. ft. after <input type="checkbox"/> hrs. pumping <input type="checkbox"/> g.p.m. Estimated maximum yield <input type="checkbox"/> g.p.m.
Well #3 Fine sand		0		14		13. Water sample submitted: <input type="checkbox"/> Yes <input checked="" type="checkbox"/> No Date 8-10-77
Gray clay		14		15		14. Well head completion: <input type="checkbox"/> Pitless adapter <input type="checkbox"/> 12 Inches above grade
Fine sand		15		27		15. Well grouted? yes With: <input checked="" type="checkbox"/> Neat cement <input type="checkbox"/> Bentonite <input type="checkbox"/> Concrete Depth: From <input type="checkbox"/> 0 ft. to 10 ft.
Brown clay		27		28		16. Nearest source of possible contamination: FIELD ft. Direction <input type="checkbox"/> Type <input type="checkbox"/> Well disinfected upon completion? <input type="checkbox"/> Yes <input checked="" type="checkbox"/> No
Fine sand		28		30		17. Pump: <input type="checkbox"/> Not installed Manufacturer's name Berkeley Pump Co. Model number B4JRB HP 80 Volts <input type="checkbox"/> Length of drop pipe 30 ft. capacity 800 g.p.m. Type: <input type="checkbox"/> Submersible <input type="checkbox"/> Turbine <input type="checkbox"/> Jet <input type="checkbox"/> Reciprocating <input checked="" type="checkbox"/> Centrifugal <input type="checkbox"/> Other
Good gravel		30		42		
Well #4 Fine sand & top soil		0		18		
Brown clay, clay streak at 33' to 34'		18		34		
Good gravel		34		42		
(Continued on Next Page)						
(Use a second sheet if needed)						
18. Elevation:		19. Remarks:		20. Water well contractor's certification: This well was drilled under my jurisdiction and this report is true to the best of my knowledge and belief. Clarke Well & Equ., Inc. 185 Business name License No. Address Great Bend, KS 67530 Signed <input type="checkbox"/> Date 1-10-78 Authorized representative		
Topography: <input type="checkbox"/> Hill <input type="checkbox"/> Slope <input type="checkbox"/> Upland <input type="checkbox"/> Valley						

USE TYPEWRITER OR BALL
POINT PEN-PRESS FIRMLY,
PRINT CLEARLY.

WATER WELL RECORD
KSA 82a-1201-1215

Kansas Department of Health and
Environment-Division of Environment
(Water well Contractors)
Topeka, Kansas 66620

PAGE -2-

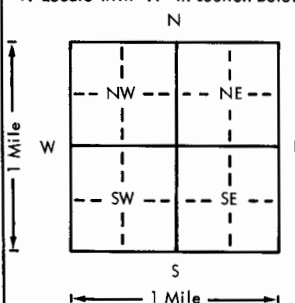1. Location of well:		County	Fraction 1/4 1/4 1/4	Section number	Township number T S R	Range number E W
2. Distance and direction from nearest town or city: Street address of well location if in city:				3. Owner of well: Dean Anthony (Continued) R.R. or street: City, state, zip code: Iuka, KS 67066		
4. Locate with "X" in section below:		Sketch map:		6. Bore hole dia. _____ in. Completion date _____ Well depth _____ ft.		
				7. _____ Cable tool _____ Rotary _____ Driven _____ Dug _____ Hollow rod _____ Jetted _____ Bored _____ Reverse rotary		
5. Type and color of material		From	To	8. Use: _____ Domestic _____ Public supply _____ Industry _____ Irrigation _____ Air conditioning _____ Stock _____ Lawn _____ Oil field water _____ Other		
Well #5				9. Casing: Material _____ Height: Above or below Threaded _____ Welded _____ Surface _____ in. RMP _____ PVC _____ Weight _____ lbs./ft. Dia. _____ in. to _____ ft. depth Wall Thickness: inches or Dia. _____ in. to _____ ft. depth gage No. _____		
Fine sandy & sandy clay		0	16	10. Screen: Manufacturer's name _____ Type _____ Dia. _____ Slot/gauze _____ Length _____ Set between _____ ft. and _____ ft. _____ ft. and _____ ft. Gravel pack? _____ Size range of material _____		
Brown clay		16	19	11. Static water level: _____ mo./day/yr. _____ ft. below land surface Date _____		
Fine sand & clay streak at 29'		19	34	12. Pumping level below land surfaces: _____ ft. after _____ hrs. pumping _____ g.p.m. _____ ft. after _____ hrs. pumping _____ g.p.m. Estimated maximum yield _____ g.p.m.		
Good gravel		34	42	13. Water sample submitted: _____ mo./day/yr. Yes _____ No _____ Date _____		
*****				14. Well head completion: _____ Pitless adapter _____ Inches above grade		
Well #6				15. Well grouted? _____ With: _____ Neat cement _____ Bentonite _____ Concrete _____ Depth: From _____ ft. to _____ ft.		
Fine sand & top soil		0	16	16. Nearest source of possible contamination: ft. _____ Direction _____ Type _____ Well disinfected upon completion? Yes _____ No _____		
Yellow - brown clay		16	22	17. Pump: _____ Not installed Manufacturer's name _____ Model number _____ HP _____ Volts _____ Length of drop pipe _____ ft. capacity _____ g.p.m. Type: _____ Submersible _____ Turbine _____ Jet _____ Reciprocating _____ Centrifugal _____ Other		
Fine sand & gravel, clay streak at 30'		22	35	20. Water well contractor's certification: This well was drilled under my jurisdiction and this report is true to the best of my knowledge and belief. Clarke Well & Eq., Inc. 185 Business name License No. Address Great Bend, KS 67530 Signed _____ Date 1-10-77 Authorized representative		
Good sand & gravel		35	42			

Well #7						
Fine sand & top soil		0	14			
Yellow clay		14	22			
Fine sand & gravel		22	32			
Good sand & gravel		32	42			
(Use a second sheet if needed)						
18. Elevation:		19. Remarks:				
Topography: _____ Hill _____ Slope _____ Upland _____ Valley						