


1 LOCATION OF WATER WELL: County: Reno NW ¼ SE ¼ NE ¼		Fraction NW ¼ SE ¼ NE ¼	Section Number 1	Township Number T 22 S	Range Number R 10 E/W	
Distance and direction from nearest town or city street address of well if located within city? <u>8½ mi W, 2½ mi S of Sterling</u>						
2 WATER WELL OWNER: KGS/GWMD#5 RR#, St. Address, Box # : City, State, ZIP Code :						Board of Agriculture, Division of Water Resources Application Number:
3 LOCATE WELL'S LOCATION WITH AN "X" IN SECTION BOX: N +--- NW ---+ NE ---+ W E +--- SW ---+ SE ---+ S ↓ 1 Mile		4 DEPTH OF COMPLETED WELL 45 ft. ELEVATION: Depth(s) Groundwater Encountered 1. ft. 2. ft. 3. ft. WELL'S STATIC WATER LEVEL . . . 29.80 . . . ft. below land surface measured on mo/day/yr . . . 3/82 Pump test data: Well water was ft. after hours pumping gpm Est. Yield gpm: Well water was ft. after hours pumping gpm Bore Hole Diameter . . . 9 7/8 in. to . . . 35 . . . ft., and . . . in. to . . . ft. WELL WATER TO BE USED AS: 5 Public water supply 8 Air conditioning 11 Injection well 1 Domestic 3 Feedlot 6 Oil field water supply 9 Dewatering 12 Other (Specify below) 2 Irrigation 4 Industrial 7 Lawn and garden only 10 Observation well Was a chemical/bacteriological sample submitted to Department? Yes No . . . x; If yes, mo/day/yr sample was submitted Water Well Disinfected? Yes No				
5 TYPE OF BLANK CASING USED: 1 Steel 3 RMP (SR) 5 Wrought iron 8 Concrete tile CASING JOINTS Glued Clamped 2 PVC 4 ABS 6 Asbestos-Cement 9 Other (specify below) Welded Blank casing diameter . . . 5 . . . in. to . . . ft., Dia . . . in. to . . . ft., Dia . . . in. to . . . ft. Casing height above land surface . . . 2.39 . . . in., weight . . . lbs./ft. Wall thickness or gauge No. . Schd #40 TYPE OF SCREEN OR PERFORATION MATERIAL: 1 Steel 3 Stainless steel 5 Fiberglass 8 RMP (SR) 10 Asbestos-cement 2 Brass 4 Galvanized steel 6 Concrete tile 9 ABS 11 Other (specify) SCREEN OR PERFORATION OPENINGS ARE: 1 Continuous slot 3 Mill slot 5 Gauzed wrapped 8 Saw cut 11 None (open hole) 2 Louvered shutter 4 Key punched 6 Wire wrapped 9 Drilled holes 3 Torch cut 10 Other (specify) SCREEN-PERFORATED INTERVALS: From . . . 10 . . . ft. to . . . 45 . . . ft., From . . . ft. to . . . ft. GRAVEL PACK INTERVALS: From . . . 35 . . . ft. to . . . 45 . . . ft., From . . . ft. to . . . ft.						
6 GROUT MATERIAL: Neat cement 2 Cement grout 3 Bentonite 4 Other Grout Intervals: From . . . 0 . . . ft. to . . . 10 . . . ft., From . . . ft. to . . . ft., From . . . ft. to . . . ft. What is the nearest source of possible contamination: Unknown 1 Septic tank 4 Lateral lines 7 Pit privy 10 Livestock pens 14 Abandoned water well 2 Sewer lines 5 Cess pool 8 Sewage lagoon 11 Fuel storage 15 Oil well/Gas well 3 Watertight sewer lines 6 Seepage pit 9 Feedyard 12 Fertilizer storage 16 Other (specify below)						
Direction from well? FROM TO LITHOLOGIC LOG FROM TO LITHOLOGIC LOG See log frm Site #24(1)						
7 CONTRACTOR'S OR LANDOWNER'S CERTIFICATION: This water well was (1) constructed, (2) reconstructed, or (3) plugged under my jurisdiction and was completed on (mo/day/year) . . . 8/13/81 . . . and this record is true to the best of my knowledge and belief. Kansas Water Well Contractor's License No. . . . This Water Well Record was completed on (mo/day/yr) . . . 9/27/83 . . . under the business name of Kansas Geological Survey by (signature) [Signature]						
INSTRUCTIONS: Use typewriter or ball point pen, PLEASE PRESS FIRMLY and PRINT clearly. Please fill in blanks, underline or circle the correct answers. Send top three copies to Kansas Department of Health and Environment, Division of Environment, Environmental Geology Section, Topeka, KS 66620. Send one to WATER WELL OWNER and retain one for your records.						

SITE NUMBER : 24
SITE LOCATION : NW SE NE
LEGAL LOCATION: SEC1 T22S R10W
COUNTY : RENO

LANDOWNER: HUGH STOUT
ADDRESS : ROUTE 1
ALDEN, KANSAS 67512
PHONE NO.: 316-278-2197

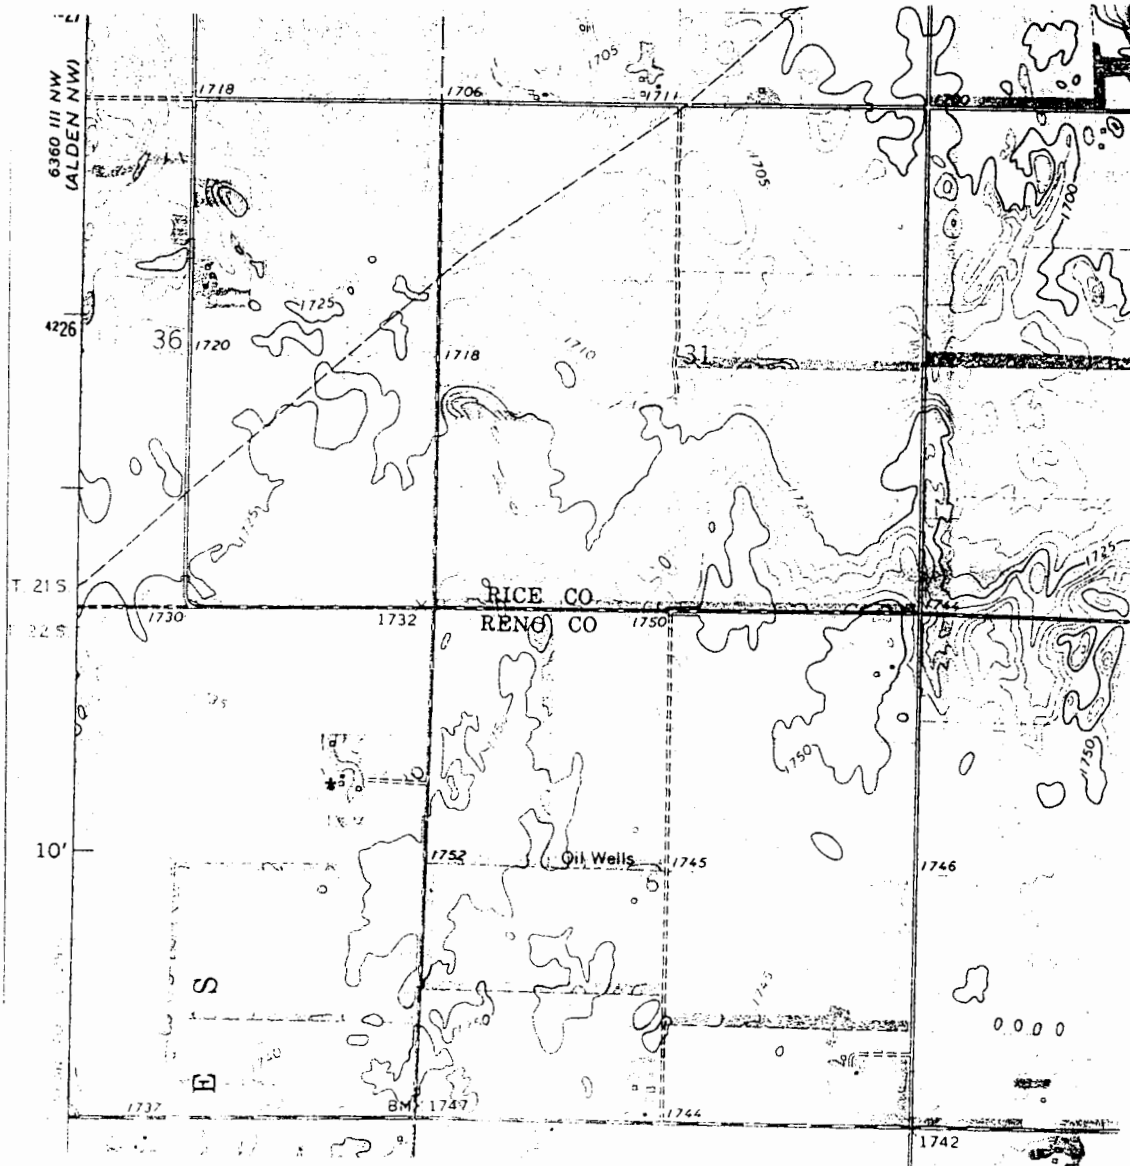

WELL LOCATION *