

WATER WELL RECORD

Form WWC-5

Division of Water Resources; App. No.

1 LOCATION OF WATER WELL: County: <u>Stafford</u>	Fraction <u>SW 1/4 SW 1/4 NE 1/4</u>	Section Number <u>29</u>	Township Number <u>T 22 S</u>	Range Number <u>R 11W E/W</u>
---	---	-----------------------------	----------------------------------	----------------------------------

Distance and direction from nearest town or city street address of well if located within city?
5E, 1/2N, 1/2E of Hudson, KS

2 WATER WELL OWNER: <u>Virgil Gatton</u> RR#, St. Address, Box # : <u>1105 NE 110th Ave.</u> City, State, ZIP Code : <u>Stafford, KS 67578</u>	Global Positioning Systems (decimal degrees, min. of 4 digits) Latitude: _____ Longitude: _____ Elevation: _____ Datum: _____ Data Collection Method: _____
---	---

3 LOCATE WELL'S LOCATION WITH AN "X" IN SECTION BOX: N <table border="1" style="margin: auto; border-collapse: collapse;"> <tr> <td style="padding: 5px;">-- NW --</td> <td style="padding: 5px;">-- NE --</td> </tr> <tr> <td style="padding: 5px;">-- SW --</td> <td style="padding: 5px;">-- SE --</td> </tr> </table> S	-- NW --	-- NE --	-- SW --	-- SE --	4 DEPTH OF COMPLETED WELL <u>83</u> ft. Depth(s) Groundwater Encountered (1)..... <u>14</u> ft. (2)..... ft. (3)..... ft. WELL'S STATIC WATER LEVEL..... <u>14</u> ft. below land surface measured on mo/day/yr. <u>03/30/09</u> . Pump test data: Well water was.....ft. after..... hours pumping..... gpm Est. Yield... <u>60</u> ...gpm: Well water was.....ft. after..... hours pumping..... gpm WELL WATER TO BE USED AS: 5 Public water supply 8 Air conditioning 11 Injection well 1 Domestic 3 Feedlot <u>6 Oil field water supply</u> 9 Dewatering 12 Other (Specify below) 2 Irrigation 4 Industrial 7 Domestic (lawn & garden) 10 Monitoring well Was a chemical/bacteriological sample submitted to Department? Yes <u>No</u>; If yes, mo/day/yr Sample was submitted..... Water well disinfected? <u>Yes</u> No
-- NW --	-- NE --				
-- SW --	-- SE --				

5 TYPE OF CASING USED: 1 Steel 3 RMP (SR) 2 PVC 4 ABS 5 Wrought Iron 6 Asbestos-Cement 7 Fiberglass 8 Concrete tile 9 Other (specify below)	CASING JOINTS: <u>Glued</u> Clamped..... Welded..... Threaded.....	Blank casing diameter <u>5</u> in. to <u>63</u> ft., Diameter in. to ft., Diameter in. to ft. Casing height above land surface..... <u>12</u> in., Weight <u>2.8</u> lbs./ft. Wall thickness or gauge No. <u>Sch. 40</u> TYPE OF SCREEN OR PERFORATION MATERIAL: 1 Steel 3 Stainless Steel 5 Fiberglass 7 PVC 9 ABS 11 Other (Specify) 2 Brass 4 Galvanized Steel 6 Concrete tile 8 RM (SR) 10 Asbestos-Cement 12 None used (open hole)
---	--	---

SCREEN OR PERFORATION OPENINGS ARE:
 1 Continuous slot 3 Mill slot 5 Gauzed wrapped 7 Torch cut 9 Drilled holes 11 None (open hole)
 2 Louvered shutter 4 Key punched 6 Wire wrapped 8 Saw cut 10 Other (specify)

SCREEN-PERFORATED INTERVALS: From.....63..... ft. to83..... ft., From ft. to ft.
 From..... ft. to ft., From ft. to ft.

GRAVEL PACK INTERVALS: From.....20..... ft. to83..... ft., From ft. to ft.
 From..... ft. to ft., From ft. to ft.

6 GROUT MATERIAL: 1 Neat cement 2 Cement grout 3 <u>Bentonite</u> 4 Other Grout Intervals: From <u>0</u> ft. to <u>20</u> ft., From ft. to ft., From ft. to ft. What is the nearest source of possible contamination: 1 Septic tank 4 Lateral lines 7 Pit privy 10 Livestock pens 13 Insecticide storage 16 Other (specify below) 2 Sewer lines 5 Cess pool 8 Sewage lagoon 11 Fuel storage 14 Abandoned water well 3 Watertight sewer lines 6 Seepage pit 9 Feedyard 12 Fertilizer storage <u>15 Oil well/gas well</u> Direction from well? <u>East</u> How many feet? <u>225</u>	LITHOLOGIC LOG <table border="1" style="width: 100%; border-collapse: collapse;"> <tr> <th>FROM</th> <th>TO</th> <th>DESCRIPTION</th> </tr> <tr> <td>0</td> <td>12</td> <td>top sand</td> </tr> <tr> <td>12</td> <td>23</td> <td>clay</td> </tr> <tr> <td>23</td> <td>83</td> <td>sand and gravel shale bottom</td> </tr> <tr><td> </td><td> </td><td> </td></tr> <tr><td> </td><td> </td><td> </td></tr> <tr><td> </td><td> </td><td> </td></tr> <tr><td> </td><td> </td><td> </td></tr> <tr><td> </td><td> </td><td> </td></tr> <tr><td> </td><td> </td><td> </td></tr> <tr><td> </td><td> </td><td> </td></tr> </table>	FROM	TO	DESCRIPTION	0	12	top sand	12	23	clay	23	83	sand and gravel shale bottom																						PLUGGING INTERVALS <table border="1" style="width: 100%; border-collapse: collapse;"> <tr> <th>FROM</th> <th>TO</th> <th>DESCRIPTION</th> </tr> <tr> <td> </td> <td> </td> <td> </td> </tr> </table>	FROM	TO	DESCRIPTION																											
FROM	TO	DESCRIPTION	
0	12	top sand	
12	23	clay	
23	83	sand and gravel shale bottom	
FROM	TO	DESCRIPTION	

7 CONTRACTOR'S OR LANDOWNER'S CERTIFICATION: This water well was (1) constructed, (2) reconstructed, or (3) plugged under my jurisdiction and was completed on (mo/day/year) 03/30/09 and this record is true to the best of my knowledge and belief.
 Kansas Water Well Contractor's License No.186..... This Water Well Record was completed on (mo/day/year) 03/31/09
 under the business name of Kelly's Water Well Service, Inc. by (signature) Kathryn A. Good

INSTRUCTIONS: Use typewriter or ball point pen. PLEASE PRESS FIRMLY and PRINT clearly. Please fill in blanks, underline or circle the correct answers. Send top three copies to Kansas Department of Health and Environment, Bureau of Water, Geology Section, 1000 SW Jackson St., Suite 420, Topeka, Kansas 66612-1367. Telephone 785-296-5522. Send one to WATER WELL OWNER and retain one for your records. Fee of \$5.00 for each constructed well. Visit us at <http://www.kdheks.gov/waterwell/index.html>.



KANSAS DEPARTMENT OF HEALTH & ENVIRONMENT

OIL FIELD WATER SUPPLY WELLS - LETTER OF TRANSFER

COPY

I, Virgil Gatton of 1105 NE 110th Ave.
(Landowner's address)
Stafford, KS 67578 am the landowner on which a water well is located in
(City) (State)
the SW quarter of the SW quarter of the NE quarter in Section 29, Township 22,
Range 11 E (W) in Stafford County, Kansas which is approximately
2970 feet (north) south, and 2145 feet east (west) of the apparent SE section
corner. The water well was drilled in March, 2009 (month/year).

I hereby request that Prolific Resources, LLC leave the water well,
(Operator name)
which was drilled by Temporary Water Permit # 20090075, unplugged, and I will
assume all responsibility for the plugging of said water well in accordance with the requirements
of the Kansas Department of Health and Environment regulation K.A.R. 28-30-7.

LANDOWNER:

Virgil R. Gatton 9/1/11
(Signature) (Date)

Virgil Gatton
(Print)

IF ADDITIONAL LANDOWNER

(Signature) (Date)

(Print)

WWC-8

OPERATOR:

Prolific Resources, LLC 9-1-11
(Signature) (Date)

By: Dan K. Wuebing
(Agent) Manager

RECEIVED

SEP 09 2011

BUREAU OF WATER

Submit To:

CHIEF ENGINEER
Division of Water Resources
Kansas Department of Agriculture
109 SW 9th Street, 2nd Floor
Topeka, KS 66612-1283
www.ksda.gov/dwr

**APPLICATION FOR
TEMPORARY PERMIT**

☒ GROUNDWATER
☐ SURFACE WATER
(check one)

WATER RESOURCES
RECEIVED

MAR 27 2009
12:54 PM

KS DEPT OF AGRICULTURE




State of Kansas

STATUTORY FILING FEE OF \$200.00 MUST ACCOMPANY THIS APPLICATION
(Make check payable to the Department of Agriculture)

20096075

- Applicant: (Please print or type)
Name Prolific Resources, LLC
Street 272
City and State _____
Zip Code 67 -2258
Social Security _____
and/or Taxpayer _____
- Location of place of use:
SW SW NE Sec., 29-22-11 Stafford Co.
- Location of Point of Diversion:
Sec. 29 Twp. 22 Rng. 11 W
Stafford County, Kansas.
Distance from Southeast Corner of Section:
2970 feet North from Southeast Corner
2145 feet West from Southeast Corner
Existing water right? Yes ☐ No ☒
If yes, File No. _____
Pending application? Yes ☐ No ☒
If yes, File No. _____
- Period of use (6 months maximum):
Commencing date: March 28, 2009
Ending Date: September 28, 2009
- Location of the proposed point of diversion shall be indicated on the diagram below. Use the center section.
If surface water, indicate on the diagram the course of the stream, and its name.
The scale of the diagram is 2 inches = 1 mile
Each small square represents 10 acres
- Water Use Data:
Proposed Max. Pumping Rate (gpm) 60
Amount Requested (gallons) 300,000
(not to exceed one million gallons unless for dewatering)
Depth of Well (feet) 100' max. OR
Name of Stream _____
- Name, address and upon which point:
Virgil C
1105 NE 1
If other than applicant permission to install (attach if applicable)
KS 78 d
- Water is to be used for:
Drilling Operations--Oil & Gas

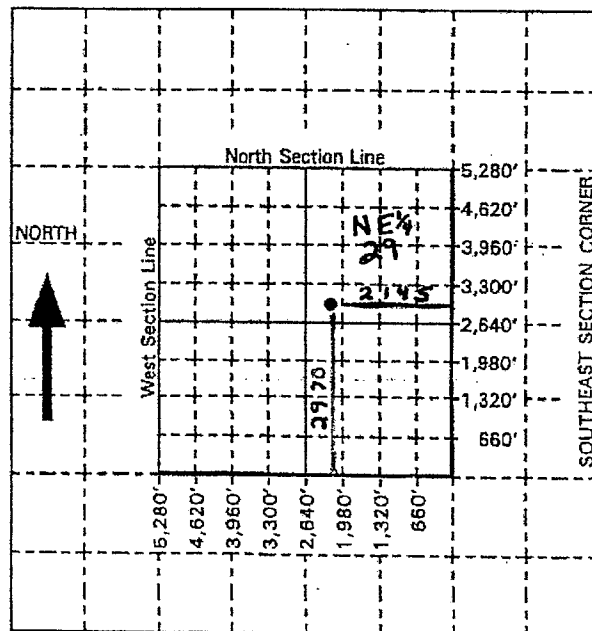

For Office Use Only: Code TMP Fee \$ 200 TR # _____ Receipt Date 3-27-09 Check # 1714