



ASSIGNMENT OF WATER WELL TO LANDOWNER

I, David Figger of P.O. Box 112
(Landowner's address)

Hudson KS 67545 am the landowner on which a water well is located in
(City) (State)
the NE quarter of the SW quarter of the SW quarter in Section 28, Township 22,
Range 11 ~~E/W~~, in Stafford County, Kansas which is approximately
110' East Southeast
634 feet ~~north~~/south, and 744 feet ~~east~~/west of the apparent ~~SW~~ section
corner. The water well was drilled in 12/2011 (month/year).

I hereby request that L. D. Drilling, Inc. leave the water well,
(Operator name)

which was drilled by Temporary Water Permit # 20110567, unplugged, and I will
assume all responsibility for the plugging of said water well in accordance with the requirements
of the Kansas Department of Health and Environment regulation K.A.R. 28-30-7.

LANDOWNER:

David Figger 6-1-12
(Signature) (Date)

David L Figger
(Print)

OPERATOR:

Susan Schewies 5-29-12
(Signature) (Date)

By: Susan Schewies
(Agent) L D Drilling, Inc.

IF ADDITIONAL LANDOWNER

(Signature) (Date)

(Print)

WATER WELL RECORD

Form WWC-5

Division of Water Resources App. No.


20110567

1 LOCATION OF WATER WELL: County: Stafford	Fraction ¼ NE ¼ SW ¼ SW ¼	Section Number 28	Township No. T 22 S	Range Number R 11 <input type="checkbox"/> E <input checked="" type="checkbox"/> W
---	-------------------------------------	-----------------------------	-------------------------------	--

Street/Rural Address of Well Location; if unknown, distance & direction from nearest town or intersection: If at owner's address, check here .
5E, 1/2N, 1E of Hudson, KS

Global Positioning System (GPS) information:
 Latitude: (in decimal degrees)
 Longitude: (in decimal degrees)
 Elevation:
 Datum: WGS 84, NAD 83, NAD 27
 Collection Method:
 GPS unit (Make/Model:)
 Digital Map/Photo, Topographic Map, Land Survey
 Est. Accuracy: <3 m, 3-5 m, 5-15 m, >15 m

2 WATER WELL OWNER: **David Fiqar**
 RR#, Street Address, Box #: **Box 112**
 City, State, ZIP Code : **Hudson, KS 67545**

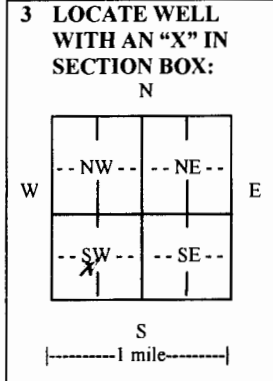

4 DEPTH OF COMPLETED WELL **80** ft.
 Depth(s) Groundwater Encountered (1) **7** ft. (2) ft. (3) ft.
 WELL'S STATIC WATER LEVEL **7** ft. below land surface measured on mo/day/yr. **12/7/11**
 Pump test data: Well water was ft. after hours pumping gpm
 EST. YIELD **80** gpm. Well water was ft. after hours pumping gpm
 Bore Hole Diameter in. to ft., and in. to ft.
 WELL WATER TO BE USED AS: Public water supply Geothermal Injection well
 Domestic Feedlot Oil field water supply Dewatering Other (Specify below)
 Irrigation Industrial Domestic-lawn & garden Monitoring well
 Was a chemical/bacteriological sample submitted to Department? Yes No
 If yes, mo/day/yr sample was submitted
 Water well disinfected? Yes No

5 TYPE OF CASING USED: Steel PVC Other
 CASING JOINTS: Glued Clamped Welded Threaded
 Casing diameter **5** in. to **60** ft., Diameter in. to ft., Diameter in. to ft.
 Casing height above land surface **12** in., Weight **2.8** lbs./ft., Wall thickness or gauge No. **Sch. 40**
 TYPE OF SCREEN OR PERFORATION MATERIAL:
 Steel Stainless Steel PVC Other (Specify)
 Brass Galvanized Steel None used (open hole)
 SCREEN OR PERFORATION OPENINGS ARE:
 Continuous slot Mill slot Gauze wrapped Torch cut Drilled holes None (open hole)
 Louvered shutter Key punched Wire wrapped Saw cut Other (specify)
 SCREEN-PERFORATED INTERVALS: From **60** ft. to **80** ft., From ft. to ft.
 From ft. to ft., From ft. to ft.
 GRAVEL PACK INTERVALS: From **20** ft. to **80** ft., From ft. to ft.
 From ft. to ft., From ft. to ft.

6 GROUT MATERIAL: Neat cement Cement grout Bentonite Other
 Grout Intervals: From **0** ft. to **20** ft., From ft. to ft., From ft. to ft.
 What is the nearest source of possible contamination:
 Septic tank Lateral lines Pit privy Livestock pens Insecticide storage Other (specify below)
 Sewer lines Cesspool Sewage lagoon Fuel storage Abandoned water well
 Watertight sewer lines Seepage pit Feedyard Fertilizer storage Oil well/gas well
 Direction from well **East Southeast** Distance from well **110**

FROM	TO	LITHOLOGIC LOG	FROM	TO	LITHO. LOG (cont.) or PLUGGING INTERVALS
0	2	top soil			
2	65	clay			
65	80	sand and gravel			
					L. D. Drilling, Inc.
					7 SW 26 Ave.
					Great Bend, KS 67530

7 CONTRACTOR'S OR LANDOWNER'S CERTIFICATION: This water well was constructed, reconstructed, or plugged under my jurisdiction and was completed on (mo/day/year) **12/8/11** and this record is true to the best of my knowledge and belief. Kansas Water Well Contractor's License No. **186** This Water Well Record was completed on (mo/day/year) **01/04/12** under the business name of **Kelly's Water Well Service, Inc.** by (signature) *Kathleen L. Wood*

INSTRUCTIONS: Use typewriter or ball point pen. **PLEASE PRESS FIRMLY** and **PRINT** clearly. Please fill in blanks and check the correct answers. Send three copies (white, blue, pink) to Kansas Department of Health and Environment, Bureau of Water, Geology Section, 1000 SW Jackson St., Suite 420, Topeka, Kansas 66612-1367. Telephone 785-296-5524. Send one copy to WATER WELL OWNER and retain one for your records. Include fee of \$5.00 for each constructed well. Visit us at <http://www.kdheks.gov/waterwell/index.html>.



May 10, 2012

L D DRILLING
7 SW 26TH AVE
GREAT BEND, KS 67530

Re: Appropriation of Water, Application Number 20110567 00

Dear Sir/Madam:

The Division of Water Resources, Kansas Department of Agriculture (DWR) has notified the Kansas Department of Health and Environment (KDHE) the above described Temporary Permit has been issued. The Temporary Permit originally authorized the use of groundwater to be withdrawn by means of the water supply well located as described below:

1 well located in the SE SW SW of SECT 28, T22S, R11W, Stafford County, Kansas.

Temporary Permits are issued for a duration of 6 months by the DWR. After the Temporary Permit expires KDHE considers the water well abandoned and Kansas Administrative Regulation (K.A.R.) 28-30-7(a) requires abandoned water wells to be plugged or caused to be plugged by the landowner. Once a water well has been plugged, K.A.R. 28-30-4 requires a plugging report (Form WWC-5 or WWC-5 AP@) to be completed and returned to KDHE.

Please answer the following question concerning the water well. Sign on the signature line and return this letter to: KDHE, Attn: Geology Section, Bureau of Water, 1000 SW Jackson St., Suite 420, Topeka, Kansas 66612-1367 within two weeks from the date of this letter. If this form is not returned within two weeks, this may result in a follow-up by KDHE to determine the status of the well. If you have questions or need assistance with the form please contact Richard Harper at (785) 296-3565 or by e-mail at rharper@kdheks.gov.

Sincerely,

Richard Harper, LG
Water Well Unit Chief
Geology Section/Bureau of Water

cc: KDHE
SWDO
Stafford 04

L. D. DRILLING, INC.

7 SW 26 AVE.
GREAT BEND, KS 67530
620-793-3051

COPY

June 1, 2012


Kansas Department of Health & Environment
Geology Section, Bureau of Water
1000 SW Jackson St., Suite 420
Topeka, KS 66612-1367

RE: Water Well Permit #20110567
SE SW SW Sec 28-22-11
Stafford Co., KS

Dear Sir:

In accordance with the requirements of Article 30 of the Rules & Regulations as adopted by the
Kansas Department of Health & Environment.

Respectfully,

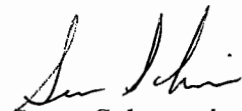

Susan Schneweis
Clerk

encl.

RECEIVED

JUN 04 2012

BUREAU OF WATER