

WATER WELL RECORD

Form WWC-5


Division of Water Resources App. No.

20140905

1 LOCATION OF WATER WELL: County: Stafford	Fraction ¼ NW ¼ NW ¼ SE ¼	Section Number 22	Township No. T 22 S	Range Number R 11 <input type="checkbox"/> E <input checked="" type="checkbox"/> W
---	-------------------------------------	-----------------------------	-------------------------------	--

Street/Rural Address of Well Location; if unknown, distance & direction from nearest town or intersection: If at owner's address, check here <input type="checkbox"/> 7E, 1N of Hudson, KS	Global Positioning System (GPS) information: Latitude: (in decimal degrees) Longitude: (in decimal degrees) Elevation: Datum: <input type="checkbox"/> WGS 84, <input type="checkbox"/> NAD 83, <input type="checkbox"/> NAD 27 Collection Method: <input type="checkbox"/> GPS unit (Make/Model:) <input type="checkbox"/> Digital Map/Photo, <input type="checkbox"/> Topographic Map, <input type="checkbox"/> Land Survey Est. Accuracy: <input type="checkbox"/> <3 m, <input type="checkbox"/> 3-5 m, <input type="checkbox"/> 5-15 m, <input type="checkbox"/> >15 m
--	--

2 WATER WELL OWNER: James Alan Sleeper RR#, Street Address, Box #: 644 W San Francisco St. City, State, ZIP Code : Santa Fe, NM 87501-1490	
--	--

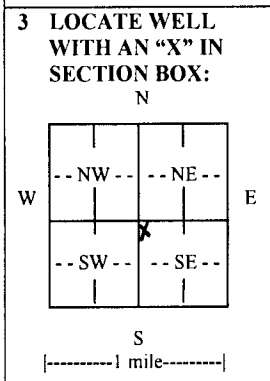

4 DEPTH OF COMPLETED WELL **63** ft.

Depth(s) Groundwater Encountered (1). **19** ft. (2)..... ft. (3)..... ft.

WELL'S STATIC WATER LEVEL **19** ft. below land surface measured on mo/day/yr. **10/24/14**.....

Pump test data: Well water wasft. after..... hours pumping..... gpm

EST. YIELD. **50**.....gpm. Well water wasft. after..... hours pumping..... gpm

Bore Hole Diameterin. toft., andin. toft.

WELL WATER TO BE USED AS: Public water supply Geothermal Injection well
 Domestic Feedlot Oil field water supply Dewatering Other (Specify below)
 Irrigation Industrial Domestic-lawn & garden Monitoring well

Was a chemical/bacteriological sample submitted to Department? Yes No

If yes, mo/day/yr sample was submitted.....

Water well disinfected? Yes No

5 TYPE OF CASING USED: Steel PVC Other

CASING JOINTS: Glued Clamped Welded Threaded

Casing diameter **.5**..... in. to **.43**..... ft., Diameter in. to ft., Diameter in. to ft.

Casing height above land surface **.12**..... in., Weight **2.8**.....lbs./ft., Wall thickness or gauge No. **Sch. 40**.....

TYPE OF SCREEN OR PERFORATION MATERIAL:
 Steel Stainless Steel PVC Other (Specify)

Brass Galvanized Steel None used (open hole)

SCREEN OR PERFORATION OPENINGS ARE:
 Continuous slot Mill slot Gauze wrapped Torch cut Drilled holes None (open hole)
 Louvered shutter Key punched Wire wrapped Saw cut Other (specify)

SCREEN-PERFORATED INTERVALS: From **.43**..... ft. to **.63**..... ft., From ft. to ft.

GRAVEL PACK INTERVALS: From **.23**..... ft. to **.63**..... ft., From ft. to ft.

6 GROUT MATERIAL: Neat cement Cement grout Bentonite Other

Grout Intervals: From **0**..... ft. to **.23**..... ft., From ft. to ft., From ft. to ft.

What is the nearest source of possible contamination:
 Septic tank Lateral lines Pit privy Livestock pens Insecticide storage Other (specify below)
 Sewer lines Cesspool Sewage lagoon Fuel storage Abandoned water well
 Watertight sewer lines Seepage pit Feedyard Fertilizer storage Oil well/gas well

Direction from well **South Southwest**..... Distance from well **.135**.....

FROM	TO	LITHOLOGIC LOG	FROM	TO	LITHO. LOG (cont.) or PLUGGING INTERVALS
0	3	top sand			
3	54	clay			J-Bar #1
54	57	broken sand rock			
57	63	shale			Sterling Drilling Company
					P O Box 1006
					Pratt, KS 67124

7 CONTRACTOR'S OR LANDOWNER'S CERTIFICATION: This water well was constructed, reconstructed, or plugged under my jurisdiction and was completed on (mo/day/year) **.10/24/14**..... and this record is true to the best of my knowledge and belief. Kansas Water Well Contractor's License No. **.186**..... This Water Well Record was completed on (mo/day/year) **.10/27/14**..... under the business name of **Kelly's Water Well Service Inc.**..... by (signature) *Kathleen L. Wood*.....

INSTRUCTIONS: Use typewriter or ball point pen. *PLEASE PRESS FIRMLY* and *PRINT* clearly. Please fill in blanks and check the correct answers. Send one copy to Kansas Department of Health and Environment, Bureau of Water, Geology Section, 1000 SW Jackson St., Suite 420, Topeka, Kansas 66612-1367. Telephone 785-296-5524. Send one copy to WATER WELL OWNER and retain one for your records. Include fee of \$5.00 for each constructed well. Visit us at <http://www.kdheks.gov/waterwell/index.html>



ASSIGNMENT OF WATER WELL TO LANDOWNER

I, James Alan Sleeper of 644 W San Fransisco St
(Landowner's address)

Santa Fe NM 87501-1490 am the landowner on which a water well is located in
(City) (State)
the NW quarter of the NW quarter of the SE quarter in Section 22, Township 22s,
Range 11 ECW, in Stafford County, Kansas which is approximately
2210 feet north south, and 2360 feet east west of the apparent SE section
corner. The water well was drilled in October 2014 (month/year).

I hereby request that Hutchinson Oil Co/Sterling Drilling Co leave the water well,
(Operator name)
which was drilled by Temporary Water Permit # 20140905, unplugged, and I will
assume all responsibility for the plugging of said water well in accordance with the requirements
of the Kansas Department of Health and Environment regulation K.A.R. 28-30-7.

LANDOWNER:

James Alan Sleeper
(Signature) 1/27/2015
James Alan Sleeper
(Print)

OPERATOR:

Sam Jalko 11/26/14
(Signature) (Date)
By: Gary M Talbott/Operations Mgr SDC
(Agent)

IF ADDITIONAL LANDOWNER

(Signature) (Date)

(Print)

RECEIVED
JAN 26 2015
BUREAU OF WATER