


1 LOCATION OF WATER WELL: County: <u>Stafford</u>	Fraction <u>NE</u> $\frac{1}{4}$ <u>SE</u> $\frac{1}{4}$ <u>NW</u> $\frac{1}{4}$	Section Number <u>7</u>	Township Number <u>T 22</u> <u>S</u>	Range Number <u>R 11W</u> <u>E/W</u>
--	---	----------------------------	---	---

Distance and direction from nearest town or city street address of well if located within city?

~~XXXXXX~~ 4 E, 9 N of Hudson, Kansas

2 WATER WELL OWNER: <u>Hammeke Brothers</u> H-30 Drilling RR#, St. Address, Box # <u>Ellinwood, Kansas 251 N. Water, Suite 10</u> City, State, ZIP Code <u>67526</u> <u>Wichita, Kansas 67202</u>	Hammeke 5-7 Board of Agriculture, Division of Water Resources Application Number: <u>900401</u>
---	---

3 LOCATE WELL'S LOCATION WITH AN "X" IN SECTION BOX:	4 DEPTH OF COMPLETED WELL: <u>42</u> ft. ELEVATION: <u>Unknown</u> Depth(s) Groundwater Encountered <u>1</u> <u>3</u> ft. 2. . . . ft. 3. . . . ft. WELL'S STATIC WATER LEVEL . . . <u>3</u> ft. below land surface measured on mo/day/yr . . . <u>8/18/90</u>
--	--

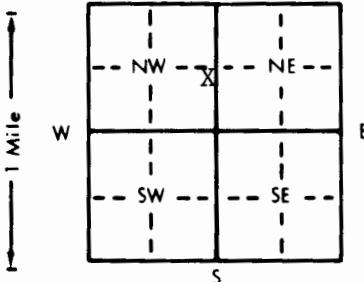

Pump test data: Well water was . . . . . ft. after . . . . . hours pumping . . . . . gpm Est. Yield . . . . <u>60</u> gpm: Well water was . . . . . ft. after . . . . . hours pumping . . . . . gpm Bore Hole Diameter <u>8</u> . . . . . in. to <u>42</u> . . . . . ft., and . . . . . in. to . . . . . ft.	WELL WATER TO BE USED AS: 1 Domestic      3 Feedlot      6 <u>Oil field water supply</u> 9 Dewatering      12 Other (Specify below) 2 Irrigation      4 Industrial      7 Lawn and garden only      10 Monitoring well
Was a chemical/bacteriological sample submitted to Department? Yes . . . . . <u>No</u> . . . . .; If yes, mo/day/yr sample was submitted . . . . .	
Water Well Disinfected? Yes . . . . . <u>No</u> . . . . .	

5 TYPE OF BLANK CASING USED: 1 <u>Steel</u> 3 RMP (SR) 2 <u>PVC</u> 4 ABS	5 Wrought iron      8 Concrete tile 6 Asbestos-Cement      9 Other (specify below) 7 Fiberglass	CASING JOINTS: <u>Glued</u> . . . . . Clamped . . . . . Welded . . . . . Threaded . . . . .
---	---	---

Blank casing diameter . . . . 5 . . . . in. to 22 . . . . ft., Dia . . . . in. to . . . . ft., Dia . . . . in. to . . . . ft.  
 Casing height above land surface . . . . 12 . . . . in., weight . . . . 2.8 . . . . lbs./ft. Wall thickness or gauge No. Sch. 40

TYPE OF SCREEN OR PERFORATION MATERIAL: 1 Steel      3 Stainless steel      5 Fiberglass 2 Brass      4 Galvanized steel      6 Concrete tile	7 <u>PVC</u> 10 Asbestos-cement 8 RMP (SR)      11 Other (specify) . . . . . 9 ABS      12 None used (open hole)
---	--

SCREEN OR PERFORATION OPENINGS ARE: 1 Continuous slot      3 Mill slot 2 Louvered shutter      4 Key punched	5 Gauzed wrapped      8 <u>Saw cut</u> 11 None (open hole) 6 Wire wrapped      9 Drilled holes 7 Torch cut      10 Other (specify) . . . . .
--	--

SCREEN-PERFORATED INTERVALS: From . . . . <u>22</u> . . . . ft. to <u>42</u> . . . . ft., From . . . . ft. to . . . . ft. From . . . . ft. to . . . . ft., From . . . . ft. to . . . . ft.	GRAVEL PACK INTERVALS: From . . . . <u>20</u> . . . . ft. to <u>42</u> . . . . ft., From . . . . ft. to . . . . ft. From . . . . ft. to . . . . ft., From . . . . ft. to . . . . ft.
---	---

6 GROUT MATERIAL: <u>1 Neat cement</u>	2 Cement grout	3 Bentonite	4 Other . . . . .
--	----------------	-------------	-------------------

Grout Intervals: From . . . . 0 . . . . ft. to 20 . . . . ft., From . . . . ft. to . . . . ft., From . . . . ft. to . . . . ft.

What is the nearest source of possible contamination:  
 1 Septic tank      4 Lateral lines      7 Pit privy      10 Livestock pens      14 Abandoned water well  
 2 Sewer lines      5 Cess pool      8 Sewage lagoon      11 Fuel storage      15 Oil well/Gas well  
 3 Watertight sewer lines      6 Seepage pit      9 Feedyard      12 Fertilizer storage      16 Other (specify below)  
 13 Insecticide storage . . . . .

Direction from well? South      How many feet? 60

FROM	TO	LITHOLOGIC LOG	FROM	TO	PLUGGING INTERVALS
0	5	Clay			
5	42	Sand and gravel			

7 CONTRACTOR'S OR LANDOWNER'S CERTIFICATION: This water well was (1) <u>constructed</u> , (2) reconstructed, or (3) plugged under my jurisdiction and was completed on (mo/day/year) . . . . . <u>8/18/90</u> . . . . . and this record is true to the best of my knowledge and belief. Kansas Water Well Contractor's License No. . . . . <u>186</u> . . . . . This Water Well Record was completed on (mo/day/yr) . . . . . <u>12/17/90</u> under the business name of <u>Kelly's Water Well Service</u> by (signature) <u>[Signature]</u>	
--	--

INSTRUCTIONS: Use typewriter or ball point pen. PLEASE PRESS FIRMLY and PRINT clearly. Please fill in blanks, underline or circle the correct answers. Send top three copies to Kansas Department of Health and Environment, Bureau of Water, Topeka, Kansas 66620-7320. Telephone: 913-296-5545. Send one to WATER WELL OWNER and retain one for your records.