

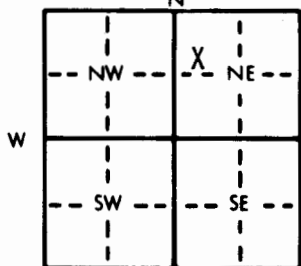
LOCATION OF WATER WELL:	Fraction	Section Number	Township Number	Range Number
County: <u>Stafford</u>	<u>SW</u> $\frac{1}{4}$ <u>NW</u> $\frac{1}{4}$ <u>NE</u> $\frac{1}{4}$	<u>18</u>	<u>T</u> <u>22</u> <u>S</u>	<u>R</u> <u>11</u> <u>X</u> <u>W</u>

Distance and direction from nearest town or city street address of well if located within city?

5 E, 2½ N of Hudson, Kansas

WATER WELL OWNER:	<u>Larry Panning</u>	<u>H-30, Inc.</u>	<u>Pannin #2-18</u>
RR#, St. Address, Box #:	<u>Ellinwood, KS</u>	<u>251 N. Water #10</u>	<u>Board of Agriculture, Division of Water Resources</u>
City, State, ZIP Code:	<u>67526</u>	<u>Wichita, KS 67202</u>	<u>Application Number: T87-466</u>

LOCATE WELL'S LOCATION WITH AN "X" IN SECTION BOX:


WELL WATER TO BE USED AS:

1 Domestic	3 Feedlot	6 Oil field water supply	9 Dewatering	11 Injection well
2 Irrigation	4 Industrial	7 Lawn and garden only	10 Observation well	12 Other (Specify below)

Was a chemical/bacteriological sample submitted to Department? Yes No X; If yes, mo/day/yr sample was submittedWater Well Disinfected? Yes No

TYPE OF BLANK CASING USED:

1 Steel	3 RMP (SR)	5 Wrought iron	8 Concrete tile	CASING JOINTS: Glued <u>X</u> Clamped <u>.....</u>
2 PVC	4 ABS	6 Asbestos-Cement	9 Other (specify below)	Welded <u>.....</u>
		7 Fiberglass		Threaded <u>.....</u>


TYPE OF SCREEN OR PERFORATION MATERIAL:

1 Steel	3 Stainless steel	5 Fiberglass	7 PVC	10 Asbestos-cement
2 Brass	4 Galvanized steel	6 Concrete tile	8 RMP (SR)	11 Other (specify) <u>.....</u>
			9 ABS	12 None used (open hole)

SCREEN OR PERFORATION OPENINGS ARE:

1 Continuous slot	3 Mill slot	5 Gauzed wrapped	8 Saw cut	11 None (open hole)
2 Louvered shutter	4 Key punched	6 Wire wrapped	9 Drilled holes	
		7 Torch cut	10 Other (specify) <u>.....</u>	


What is the nearest source of possible contamination:

1 Septic tank	4 Lateral lines	7 Pit privy	10 Livestock pens	14 Abandoned water well
2 Sewer lines	5 Cess pool	8 Sewage lagoon	11 Fuel storage	15 Oil well/Gas well
3 Watertight sewer lines	6 Seepage pit	9 Feedyard	12 Fertilizer storage	16 Other (specify below)
			13 Insecticide storage	

Direction from well? South How many feet? 60

FROM TO LITHOLOGIC LOG FROM TO LITHOLOGIC LOG

86' 3' Cement

CONTRACTOR'S OR LANDOWNER'S CERTIFICATION: This water well was (1) constructed, (2) reconstructed, or (3) plugged under my jurisdiction and was

completed on (mo/day/year) 10/27/87 and this record is true to the best of my knowledge and belief. KansasWater Well Contractor's License No. This Water Well Record was completed on (mo/day/yr) 2/19/88under the business name of H-30, Inc. by (signature) Pam Datchler

INSTRUCTIONS: Use typewriter or ball point pen, PLEASE PRESS FIRMLY and PRINT clearly. Please fill in blanks, underline or circle the correct answers. Send top

three copies to Kansas Department of Health and Environment, Division of Environment, Environmental Geology Section, Topeka, KS 66620. Send one to WATER WELL

OWNER and retain one for your records.

OFFICE USE ONLY

T

R

EW

SEC.

¼

¼

¼