

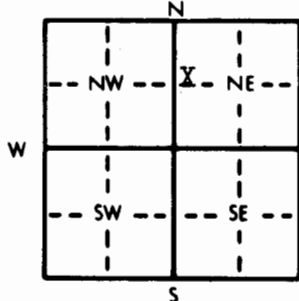
LOCATION OF WATER WELL:	Fraction	Section Number	Township Number	Range Number
County: <u>Stafford</u>	<u>SW</u> $\frac{1}{4}$ <u>NW</u> $\frac{1}{4}$ <u>NE</u> $\frac{1}{4}$	<u>18</u>	<u>T 22</u> <u>S</u>	<u>R 11W</u> <u>E/W</u>

Distance and direction from nearest town or city street address of well if located within city?

5 E, 2 1/2 N of Hudson, Kansas

WATER WELL OWNER: <u>Larry Panning</u>	<u>H-30 Drilling Co.</u>	<u>Panning 2-18</u>
RR#, St. Address, Box #: <u>Ellinwood, Ks.</u>	<u>251 N. Water, Suite 10</u>	Board of Agriculture, Division of Water Resources
City, State, ZIP Code: <u>67526</u>	<u>Wichita, Kansas 67202</u>	Application Number: <u>T87-466</u>

LOCATE WELL'S LOCATION WITH AN "X" IN SECTION BOX:

DEPTH OF COMPLETED WELL: 86 ft. ELEVATION: UnknownDepth(s) Groundwater Encountered 1.31 ft. 2. 31 ft. 3. 10/20/87 ft.WELL'S STATIC WATER LEVEL 31 ft. below land surface measured on mo/day/yrPump test data: Well water was 60 gpm: Well water was 8 ft. after 86 hours pumping gpmEst. Yield 60 gpm: Well water was 8 ft. after 86 hours pumping gpmBore Hole Diameter 8 in. to 86 ft., and 8 in. to 86 ft.

WELL WATER TO BE USED AS: 5 Public water supply 8 Air conditioning 11 Injection well

1 Domestic 3 Feedlot 6 Oil field water supply 9 Dewatering 12 Other (Specify below)

2 Irrigation 4 Industrial 7 Lawn and garden only 10 Observation well

Was a chemical/bacteriological sample submitted to Department? Yes No; If yes, mo/day/yr sample was submittedWater Well Disinfected? Yes No

TYPE OF BLANK CASING USED:

1 Steel 3 RMP (SR) 5 Wrought iron 8 Concrete tile CASING JOINTS: Glued Clamped2 PVC 4 ABS 6 Asbestos-Cement 9 Other (specify below) WeldedBlank casing diameter 5 in. to 66 ft., Dia 12 in. to 2.8 lbs./ft. Wall thickness or gauge No. Sch. 40

TYPE OF SCREEN OR PERFORATION MATERIAL:

1 Steel 3 Stainless steel 5 Fiberglass 8 RMP (SR) 10 Asbestos-cement

2 Brass 4 Galvanized steel 6 Concrete tile 9 ABS 11 Other (specify)

SCREEN OR PERFORATION OPENINGS ARE:

1 Continuous slot 3 Mill slot 5 Gauzed wrapped 8 Saw cut 11 None (open hole)

2 Louvered shutter 4 Key punched 6 Wire wrapped 9 Drilled holes

SCREEN-PERFORATED INTERVALS:

From 66 ft. to 86 ft. From 66 ft. to 86 ft.From 66 ft. to 86 ft. From 66 ft. to 86 ft.

GRAVEL PACK INTERVALS:

From 20 ft. to 86 ft. From 20 ft. to 86 ft.From 20 ft. to 86 ft. From 20 ft. to 86 ft.

GROUT MATERIAL:

1 Neat cement 2 Cement grout 3 Bentonite 4 Other

Grout Intervals: From 0 ft. to 20 ft. From 0 ft. to 20 ft.

What is the nearest source of possible contamination:

1 Septic tank 4 Lateral lines 7 Pit privy 10 Livestock pens 14 Abandoned water well

2 Sewer lines 5 Cess pool 8 Sewage lagoon 11 Fuel storage 15 Oil well/Gas well

3 Watertight sewer lines 6 Seepage pit 9 Feedyard 12 Fertilizer storage 16 Other (specify below)

Direction from well? South How many feet? 60

FROM TO LITHOLOGIC LOG FROM TO LITHOLOGIC LOG

0 20 Clay

20 86 Fine sand and gravel