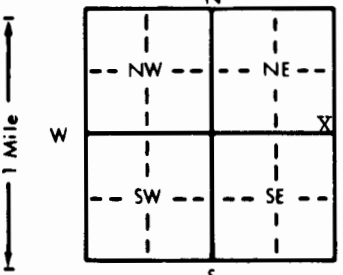


|   |    |                                                                                                  |                             |                                                |                                  |
|---|----|--------------------------------------------------------------------------------------------------|-----------------------------|------------------------------------------------|----------------------------------|
| 1 LOCATION OF WATER WELL:<br>County: <b>Stafford</b>   |    | Fraction<br><b>SE 1/4 SE 1/4 NE 1/4</b>                                                          | Section Number<br><b>30</b> | Township Number<br><b>T 22 S</b>               | Range Number<br><b>R 12W E/W</b> |
| Distance and direction from nearest town or city street address of well if located within city?<br><b>1 W of Hudson, Kansas</b>   |    |                                                                                                  |                             |                                                |                                  |
| 2 WATER WELL OWNER: <b>Norman T. Witt Sterling Drilling Co. Norman Witt 1-30</b><br>RR#, St. Address, Box #: <b>P.O. Box 87 P.O. Box 1006</b><br>City, State, ZIP Code: <b>Hudson, Ks. 67545 Pratt, Kansas 67124</b><br>Board of Agriculture, Division of Water Resources<br>Application Number:   |    |                                                                                                  |                             |                                                |                                  |
| 3 LOCATE WELL'S LOCATION WITH AN "X" IN SECTION BOX:   |    | 4 DEPTH OF COMPLETED WELL: <b>108</b> ft. ELEVATION:                                             |                             |                                                |                                  |
|   |    | Depth(s) Groundwater Encountered 1. .... ft. 2. .... ft. 3. .... ft.                             |                             |                                                |                                  |
|   |    | WELL'S STATIC WATER LEVEL <b>20</b> ft. below land surface measured on mo/day/yr <b>10/17/96</b> |                             |                                                |                                  |
|   |    | Pump test data: Well water was .... ft. after .... hours pumping .... gpm                        |                             |                                                |                                  |
|   |    | Est. Yield .... gpm: Well water was .... ft. after .... hours pumping .... gpm                   |                             |                                                |                                  |
| Bore Hole Diameter .... in. to .... ft., and .... in. to .... ft.   |    | WELL WATER <del>TO BE</del> USED AS: 5 Public water supply 8 Air conditioning 11 Injection well  |                             |                                                |                                  |
| 1 Domestic WAS 3 Feedlot 6 Oil field water supply 9 Dewatering 12 Other (Specify below)   |    | 2 Irrigation 4 Industrial 7 Lawn and garden only 10 Monitoring well                              |                             |                                                |                                  |
| Was a chemical/bacteriological sample submitted to Department? Yes.....No.....; If yes, mo/day/yr sample was submitted   |    |                                                                                                  |                             |                                                |                                  |
| Water Well Disinfected? Yes No   |    |                                                                                                  |                             |                                                |                                  |
| 5 TYPE OF BLANK CASING USED:   |    |                                                                                                  |                             |                                                |                                  |
| 1 Steel 3 RMP (SR)   |    | 5 Wrought iron 8 Concrete tile                                                                   |                             | CASING JOINTS: Glued .... Clamped ....         |                                  |
| 2 PVC 4 ABS   |    | 6 Asbestos-Cement 9 Other (specify below)                                                        |                             | Welded ....                                    |                                  |
| Blank casing diameter .... in. to .... ft., Dia   |    | 7 Fiberglass                                                                                     |                             | Threaded ....                                  |                                  |
| Casing height above land surface <b>3 ft. below</b> in., weight .... lbs./ft. Wall thickness or gauge No. ....   |    |                                                                                                  |                             |                                                |                                  |
| TYPE OF SCREEN OR PERFORATION MATERIAL:   |    |                                                                                                  |                             |                                                |                                  |
| 1 Steel 3 Stainless steel   |    | 5 Fiberglass 8 RMP (SR)                                                                          |                             | 10 Asbestos-cement                             |                                  |
| 2 Brass 4 Galvanized steel   |    | 6 Concrete tile 9 ABS                                                                            |                             | 11 Other (specify) ....                        |                                  |
| 12 None used (open hole)   |    |                                                                                                  |                             |                                                |                                  |
| SCREEN OR PERFORATION OPENINGS ARE:   |    |                                                                                                  |                             |                                                |                                  |
| 1 Continuous slot 3 Mill slot   |    | 5 Gauzed wrapped 8 Saw cut                                                                       |                             | 11 None (open hole)                            |                                  |
| 2 Louvered shutter 4 Key punched   |    | 6 Wire wrapped 9 Drilled holes                                                                   |                             |                                                |                                  |
| 7 Torch cut   |    | 10 Other (specify) ....                                                                          |                             |                                                |                                  |
| SCREEN-PERFORATED INTERVALS: From <b>20</b> ft. to <b>40</b> ft., From .... ft. to .... ft.   |    |                                                                                                  |                             |                                                |                                  |
| From .... ft. to .... ft., From .... ft. to .... ft.   |    |                                                                                                  |                             |                                                |                                  |
| GRAVEL PACK INTERVALS: From <b>20</b> ft. to <b>93</b> ft., From .... ft. to .... ft.   |    |                                                                                                  |                             |                                                |                                  |
| From .... ft. to .... ft., From .... ft. to .... ft.   |    |                                                                                                  |                             |                                                |                                  |
| 6 GROUT MATERIAL: 1 Neat cement 2 Cement grout 3 Bentonite 4 Other   |    |                                                                                                  |                             |                                                |                                  |
| Grout Intervals: From .... ft. to .... ft., From .... ft. to .... ft., From .... ft. to .... ft.   |    |                                                                                                  |                             |                                                |                                  |
| What is the nearest source of possible contamination:   |    |                                                                                                  |                             |                                                |                                  |
| 1 Septic tank 4 Lateral lines   |    | 7 Pit privy                                                                                      |                             | 10 Livestock pens 14 Abandoned water well      |                                  |
| 2 Sewer lines 5 Cess pool   |    | 8 Sewage lagoon                                                                                  |                             | 11 Fuel storage 15 Oil well/Gas well           |                                  |
| 3 Watertight sewer lines 6 Seepage pit   |    | 9 Feedyard                                                                                       |                             | 12 Fertilizer storage 16 Other (specify below) |                                  |
| 13 Insecticide storage   |    |                                                                                                  |                             |                                                |                                  |
| Direction from well? How many feet?   |    |                                                                                                  |                             |                                                |                                  |
| FROM   | TO | LITHOLOGIC LOG                                                                                   | FROM                        | TO                                             | PLUGGING INTERVALS               |
|   |    |                                                                                                  | 108                         | 20                                             | Sand and gravel                  |
|   |    |                                                                                                  | 20                          | 3                                              | Bentonite                        |
|   |    |                                                                                                  | 3                           | 0                                              | Top soil                         |
| 7 CONTRACTOR'S OR LANDOWNER'S CERTIFICATION: This water well was (1) constructed, (2) reconstructed, or (3) plugged under my jurisdiction and was completed on (mo/day/year) <b>10/17/96</b> and this record is true to the best of my knowledge and belief. Kansas Water Well Contractor's License No. <b>186</b> This Water Well Record was completed on (mo/day/yr) <b>10/21/96</b> under the business name of <b>Kelly's Water Well Service, Inc.</b> by (signature) <i>Norman Witt</i> |    |                                                                                                  |                             |                                                |                                  |
| INSTRUCTIONS: Use typewriter or ball point pen. PLEASE PRESS FIRMLY and PRINT clearly. Please fill in blanks, underline or circle the correct answers. Send top three copies to Kansas Department of Health and Environment, Bureau of Water, Topeka, Kansas 66620-0001. Telephone: 913-296-5545. Send one to WATER WELL OWNER and retain one for your records.   |    |                                                                                                  |                             |                                                |                                  |

OFFICE USE ONLY

T

R

E/W

SEC.

1/4

1/4

1/4