

1) LOCATION OF WATER WELL.	Fraction	Section Number	Township Number	Range Number
County: Stafford	NW ¼ SE ¼ SE ¼	29	T 23 S	R 12 E

Distance and direction from nearest town or city street address of well if located within city?


Main St. and Arcade Ave., Hudson, Kansas

21 WATER WELL OWNER:

RR#, St. Address, Box # : Stafford County Flour Mill
City, State, ZIP Code : Main Street & Arcade Ave
Hudson, KS 67545

Board of Agriculture, Division of Water Resources
Application Number: _____

3] LOCATE WELL'S LOCATION
WITH AN "X" IN SECTION BOX

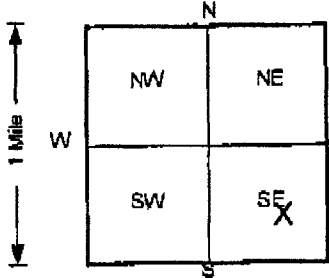

4 DEPTH OF COMPLETED WELL

Depth(s) Groundwater Encountered 1. 999 ft 2. ft 3. ft

WELL'S STATIC WATER LEVEL ft below land surface measured on mo/day/yr :

Pump test data: Well water was NA ft after hours pumping gpm

Est. Yield NA gpm: Well water was ft after hours pumping gpm

Bore Hole Diameter 8.63 in. to 18 ft. and in. to ft.

WELL WATER TO BE USED AS:

5 Public water supply	8 Air conditioning	11 Injection well		
1 Domestic	3 Feedlot	6 Oil field water supply	9 Dewatering	12 Other (Specify below)
2 Irrigation	4 Industrial	7 Lawn and garden only	10 Monitoring well	

Was a chemical/bacteriological sample submitted to Department Yes.....No.....; If yes, mo/day/yr sample was submitted

Water Well Disinfected? Yes No ✓

5 TYPE OF BLANK CASING USED:

- | | | | | |
|---------|------------|-------------------|-------------------------|--------------|
| 1 Steel | 3 RMP (SR) | 6 Asbestos-Cement | 9 Other (specify below) | Welded |
| 2 PVC | 4 ABS | 7 Fiberglass | | Threaded. ✓ |

Blank casing diameter 4 in. to 8 ft. Dia in. to ft. Dia in. to ft.
Casing height above land surface 0 in. weight Sch 40 lbs./ft. Wall thickness or gauge No.

TYPE OF SCREEN OR PERFORATION MATERIAL

- | | | | | |
|---------|--------------------|-----------------|------------|--------------------------|
| 1 Steel | 3 Stainless steel | 5 Fiberglass | 8 RMP (SR) | 11 Other (specify) _____ |
| 2 Brass | 4 Galvanized steel | 6 Concrete tile | 9 ABS | 12 None used (open hole) |

SCREEN OR PERFORATION OPENINGS ARE:

- 1 Continuous slot **3 Mill slot** 6 Wire wrapped 9 Drilled holes
2 Louvered shutter 4 Key punched 7 Torch cut 10 Other (specify)

SCREEN-PERFORATED INTERVALS

GRAVEL PACK INTERVALS:		From	ft to	ft	From	ft to	ft		
		From	6	ft to	18	ft	From	ft to	ft
		From		ft to		ft	From	ft to	ft

6	GROUT MATERIAL
---	----------------

- Group Intervals: From 0 ft to 2 ft, From 2 ft to 6 ft, From ft to ft

What is the nearest source of possible contamination:

- | | | | | |
|--------------------------|-----------------|-----------------|------------------------|--------------------------|
| 1 Septic tank | 4 Lateral lines | 7 Pit privy | 11 Fuel storage | 15 On well case well |
| 2 Sewer lines | 5 Cess pool | 8 Sewage lagoon | 12 Fertilizer storage | 16 Other (specify below) |
| 3 Watertight sewer lines | 6 Seepage pit | 9 Feedyard | 13 Insecticide storage | Unknown |

Direction from well?

LITHOLOGIC LOG			PLUGGING INTERVALS		
FROM	TO		FROM	TO	
0	2	Silt, Orange Brown to Dark Brown			
2	5	Sand, Orange-Brown			
5	12	Clay, Red-Brown			
12	18	Sand, Gray			

* This well has been abandoned and plugged

VOBW-1, Tag # , Flashmount
Project Name: AG W - Countryside Service
GeoCore # 742, #

7 CONTRACTOR'S OR LANDOWNER'S CERTIFICATION:

and was completed on (mo/day/year) 11/30/98 and this record is true to the best of my knowledge and belief.
 Kansas Water Well Contractor's License No. 527 This Water Well Record was completed on (mo/day/yr) 1/27/99
 under the business name of GeoCore Services, Inc. by (signature) Dale Koll

INSTRUCTIONS: Use typewriter or ball point pen. **PLEASE PRESS FIRMLY and PRINT** clearly. Please fill in blanks, underline or circle the correct answers. Send top three copies to Kansas Department of Health and Environment, Bureau of Water, Topeka, Kansas 66620-0001. Telephone: 913-296-6543. Send one to WATER WELL OWNER and retain one for your records.