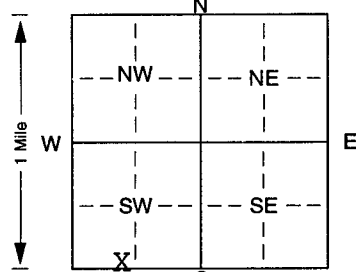


1] LOCATION OF WATER WELL: County: Stafford	Fraction SE ¼ SW ¼ SW ¼	Section Number 2	Township Number T 22 S	Range Number R 12W E/W
---	-----------------------------------	----------------------------	----------------------------------	----------------------------------

Distance and direction from nearest town or city street address of well if located within city?
3 1/2N, 2E of Hudson, Ks.

2] WATER WELL OWNER: **Harold Curtis**
 RR#, St. Address, Box # : **382 NE 150th St.**
 City, State, ZIP Code : **Hudson, Ks. 67545**
 Board of Agriculture, Division of Water Resources
 Application Number:

3] LOCATE WELL'S LOCATION WITH AN "X" IN SECTION BOX: 	4] DEPTH OF COMPLETED WELL: 111 ft. ELEVATION: unknown Depth(s) Groundwater Encountered 1. 16 ft. 2. . ft. 3. . ft. WELL'S STATIC WATER LEVEL 16 ft. below land surface measured on mo/day/yr 11/16/00 Pump test data: Well water was . ft. after . hours pumping . gpm Est. Yield 80 gpm: Well water was . ft. after . hours pumping . gpm Bore Hole Diameter. 8 in. to 11.1 ft., and . in. to . ft. WELL WATER TO BE USED AS: 5 Public water supply 8 Air conditioning 11 Injection well 1 Domestic 3 Feedlot 6 Oil field water supply 9 Dewatering 12 Other (Specify below) 2 Irrigation 4 Industrial 7 Domestic (lawn & garden) 10 Monitoring well Was a chemical/bacteriological sample submitted to Department? Yes. No. ; If yes, mo/day/yr sample was submitted Water Well Disinfected? Yes No
---	--

5] TYPE OF BLANK CASING USED: 5 Wrought iron 8 Concrete tile CASING JOINTS: Glued Clamped.
 1 Steel 3 RMP (SR) 6 Asbestos-Cement 9 Other (specify below) Welded
 2 PVC 4 ABS 7 Fiberglass Threaded.
 Blank casing diameter **5** in. to **9.1** ft., Dia in. to . ft., Dia in. to . ft.
 Casing height above land surface **12** in., weight **2.8** lbs./ft. Wall thickness or gauge No. **Sch. 40**
 TYPE OF SCREEN OR PERFORATION MATERIAL: 7 PVC 10 Asbestos-cement
 1 Steel 3 Stainless steel 5 Fiberglass 8 RMP (SR) 11 Other (specify)
 2 Brass 4 Galvanized steel 6 Concrete tile 9 ABS 12 None used (open hole)
 SCREEN OR PERFORATION OPENINGS ARE: 5 Gauzed wrapped 8 Saw cut 11 None (open hole)
 1 Continuous slot 3 Mill slot 6 Wire wrapped 9 Drilled holes
 2 Louvered shutter 4 Key punched 7 Torch cut 10 Other (specify) ft.
 SCREEN-PERFORATED INTERVALS: From **91** ft. to **111** ft., From . ft. to . ft.
 From . ft. to . ft., From . ft. to . ft.
 GRAVEL PACK INTERVALS: From **22** ft. to **111** ft., From . ft. to . ft.
 From . ft. to . ft., From . ft. to . ft.

6] GROUT MATERIAL: 1 Neat cement 2 Cement grout 3 Bentonite 4 Other
 Grout Intervals: From **0** ft. to **22** ft., From . ft. to . ft., From . ft. to . ft.
 What is the nearest source of possible contamination:
 1 Septic tank 4 Lateral lines 7 Pit privy 10 Livestock pens 14 Abandoned water well
 2 Sewer lines 5 Cess pool 8 Sewage lagoon 11 Fuel storage 15 Oil well/Gas well
 3 Watertight sewer lines 6 Seepage pit 9 Feedyard 12 Fertilizer storage 16 Other (specify below)
 13 Insecticide storage **none - in field**
 Direction from well? How many feet?

FROM	TO	LITHOLOGIC LOG	FROM	TO	PLUGGING INTERVALS
0	12	top soil			
12	65	sandy clay			
65	111	fine sand and gravel			

7] CONTRACTOR'S OR LANDOWNER'S CERTIFICATION: This water well was (1) constructed, (2) reconstructed, or (3) plugged under my jurisdiction and was completed on (mo/day/year) **11/16/00** and this record is true to the best of my knowledge and belief. Kansas Water Well Contractor's Licence No. **186** This Water Well Record was completed on (mo/day/yr) **11/17/00** under the business name of **Kelly's Water Well Service, Inc.** by (signature) *Kathryn R. Elrod*