WATER WELL RECORD Form WWC-5 KSA 82a-1212 ID No. _____

1 LOCATION OF WATER WELL: County: Stafford	Fraction: NW ¼ SW ¼ SW ¼	Section Number: 16	Township Number: T 22 S	Range Number: R 12 E/W

Distance and direction from nearest town or city street address of well if located within city?
1 3/4 north, 1/8 east of Hudson, KS

2 WATER WELL OWNER: Grady Bolding Co.
RR#, St. Address, Box #: P.O. Box 486
City, State, ZIP Code: Ellinwood, KS 67526

SFWW2035
Board of Agriculture, Division of Water Resources Application Number: 20010198

3 LOCATE WELL'S LOCATION WITH AN "X" IN SECTION BOX:

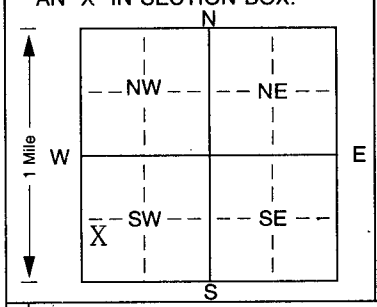

4 DEPTH OF COMPLETED WELL 106 ft. ELEVATION: .....
Depth(s) Groundwater Encountered 1. ..... ft. 2. ..... ft. 3. ..... ft.
WELL'S STATIC WATER LEVEL 21 ft. below land surface measured on mo/day/yr 10-1-01
Pump test data: Well water was ..... ft. after ..... hours pumping ..... gpm
Est. Yield NA gpm: Well water was ..... ft. after ..... hours pumping ..... gpm
Bore Hole Diameter 9 7/8 in. to 110 ft., and ..... in. to ..... ft.
WELL WATER TO BE USED AS: 5 Public water supply 8 Air conditioning 11 Injection well
1 Domestic 3 Feedlot 6 Oil field water supply 9 Dewatering 12 Other (Specify below)
2 Irrigation 4 Industrial 7 Domestic (lawn & garden) 10 Monitoring well .....
Was a chemical/bacteriological sample submitted to Department? Yes ..... No X ; If yes, mo/day/yrs sample was submitted
Water Well Disinfected? Yes No X

5 TYPE OF BLANK CASING USED: 5 Wrought iron 8 Concrete tile CASING JOINTS: Glued X Clamped .....
1 Steel 3 RMP (SR) 6 Asbestos-Cement 9 Other (specify below) Welded .....
2 PVC 4 ABS 7 Fiberglass ..... Threaded .....
Blank casing diameter 5 in. to ..... ft., Dia 86 in. to ..... ft., Dia ..... in. to ..... ft.
Casing height above land surface 24 in., weight SDR-26 lbs./ft. Wall thickness or gauge No. .....
TYPE OF SCREEN OR PERFORATION MATERIAL: 7 PVC 10 Asbestos-cement
1 Steel 3 Stainless steel 5 Fiberglass 8 RMP (SR) 11 Other (specify) .....
2 Brass 4 Galvanized steel 6 Concrete tile 9 ABS 12 None used (open hole)
SCREEN OR PERFORATION OPENINGS ARE: 5 Gauzed wrapped 8 Saw cut 11 None (open hole)
1 Continuous slot 3 Mill slot 6 Wire wrapped 9 Drilled holes
2 Louvered shutter 4 Key punched 7 Torch cut 10 Other (specify) ..... ft.
SCREEN-PERFORATED INTERVALS: From 86 ft. to 106 ft., From ..... ft. to ..... ft.
From ..... ft. to ..... ft., From ..... ft. to ..... ft.
GRAVEL PACK INTERVALS: From 110 ft. to 20 ft., From ..... ft. to ..... ft.
From ..... ft. to ..... ft., From ..... ft. to ..... ft.

6 GROUT MATERIAL: 1 Neat cement 2 Cement grout 3 Bentonite 4 Other hole plug
Grout Intervals: From 20 ft. to 0 ft., From ..... ft. to ..... ft., From ..... ft. to ..... ft.
What is the nearest source of possible contamination: 10 Livestock pens 14 Abandoned water well
1 Septic tank 4 Lateral lines 7 Pit privy 11 Fuel storage 15 Oil well/Gas well
2 Sewer lines 5 Cess pool 8 Sewage lagoon 12 Fertilizer storage 16 Other (specify below)
3 Watertight sewer lines 6 Seepage pit 9 Feedyard 13 Insecticide storage House
Direction from well? southeast How many feet? 500 ft.

FROM	TO	LITHOLOGIC LOG	FROM	TO	PLUGGING INTERVALS
0	3	sandy top soil			
3	11	gray clay			
11	29	sandy gray and tan clay			
29	74	sandy brown clay with small gravel mixed			
74	82	sand and gravel clean, small, loose with clay streaks			
82	110	sand and gravel clean, small and tight			

7 CONTRACTOR'S OR LANDOWNER'S CERTIFICATION: This water well was (1) constructed, (2) reconstructed, or (3) plugged under my jurisdiction and was completed on (mo/day/year) 10-1-01 and this record is true to the best of my knowledge and belief. Kansas Water Well Contractor's Licence No. 134 This Water Well Record was completed on (mo/day/yr) 10-5-01
under the business name of Rosencrantz-Bemis by (signature) Fredia Wadson

INSTRUCTIONS: Use typewriter or ball point pen. *PLEASE PRESS FIRMLY* and *PRINT* clearly. Please fill in blanks, underline or circle the correct answers. Send top three copies to Kansas Department of Health and Environment, Bureau of Water, Topeka, Kansas 66620-0001. Telephone 785-296-5524. Send one to WATER WELL OWNER and retain one for your records. Fee of $5.00 for each constructed well.