WATER WELL RECORD Form WWC-5 KSA 82a-1212 ID No. PMW-3

1 LOCATION OF WATER WELL: County: STAFFORD | Fraction: NW ¼ NE ¼ NE ¼ | Section Number: 32 | Township Number: T 22 S | Range Number: R 12 E/(W)

Distance and direction from nearest town or city street address of well if located within city? SOUTH AVE., HUDSON, KANSAS

2 WATER WELL OWNER: COUNTRYSIDE SERVICE

RR#, St. Address, Box # : RR1, BOX 78, HUDSON, KS. 67545

City, State, ZIP Code :

Board of Agriculture, Division of Water Resources Application Number:

3 LOCATE WELL'S LOCATION WITH AN "X" IN SECTION BOX:

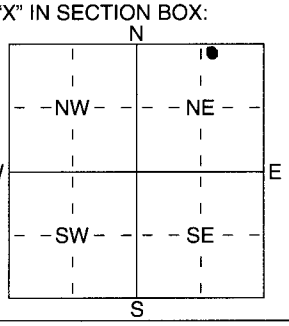

4 DEPTH OF COMPLETED WELL 30 ft. ELEVATION:

Depth(s) Groundwater Encountered 1 20 ft. 2 ft. 3 7/24/03 ft.

WELL'S STATIC WATER LEVEL 20.16 ft. below land surface measured on mo/day/yr 7/24/03

Pump test data: Well water was ft. after hours pumping gpm

Est. Yield N/A gpm: Well water was ft. after hours pumping gpm

WELL WATER TO BE USED AS: 1 Domestic 2 Irrigation 3 Feedlot 4 Industrial 5 Public water supply 6 Oil field water supply 7 Domestic (lawn & garden) 8 Air conditioning 9 Dewatering (10) Monitoring well 11 Injection well 12 Other (Specify below)

Was a chemical/bacteriological sample submitted to Department? Yes No ✓; If yes, mo/day/yrs sample was submitted

Water Well Disinfected? Yes (No)

5 TYPE OF BLANK CASING USED: 1 Steel (2) PVC 3 RMP (SR) 4 ABS 5 Wrought iron 6 Asbestos-Cement 7 Fiberglass 8 Concrete tile 9 Other (specify below)

CASING JOINTS: Glued Clamped Welded Threaded ✓

Blank casing diameter 2.375 in. to 10 ft., Dia in. to ft., Dia in. to ft.

Casing height above land surface FLUSH MOUNT in., weight lbs./ft. Wall thickness or guage No. SCH 40

TYPE OF SCREEN OR PERFORATION MATERIAL: 1 Steel 2 Brass 3 Stainless Steel 4 Galvanized Steel 5 Fiberglass 6 Concrete tile (7) PVC 8 RMP (SR) 9 ABS 10 Asbestos-Cement 11 Other (Specify) 12 None used (open hole)

SCREEN OR PERFORATION OPENINGS ARE: 1 Continuous slot 2 Louvered shutter (3) Mill slot 4 Key punched 5 Guazed wrapped 6 Wire wrapped 7 Torch cut 8 Saw cut 9 Drilled holes 10 Other (specify) 11 None (open hole)

SCREEN-PERFORATED INTERVALS: From 30 ft. to 10 ft., From ft. to ft.

From 30 ft. to 8 ft., From ft. to ft.

GRAVEL PACK INTERVALS: From 30 ft. to 8 ft., From ft. to ft.

From ft. to ft., From ft. to ft.

6 GROUT MATERIAL: 1 Neat cement 2 Cement grout (3) Bentonite (4) Other CONCRETE

Grout Intervals: From ft. to ft., From ft. to ft., From ft. to ft.

What is the nearest source of possible contamination: 1 Septic tank 2 Sewer lines 3 Watertight sewer lines 4 Lateral lines 5 Cess pool 6 Seepage pit 7 Pit privy 8 Sewage lagoon 9 Feedyard 10 Livestock pens (11) Fuel storage (FORMER) 12 Fertilizer storage 13 Insecticide storage 14 Abandoned water well 15 Oil well/Gas well 16 Other (specify below)

Direction from well? SOUTH How many feet? 15

FROM	TO	LITHOLOGIC LOG	FROM	TO	PLUGGING INTERVALS
0	0.5	ASPHALT			
0.5	4	DK BN-BLK SANDY CLAY, HARD, DRY, SL ODOR			FLUSH MOUNT WELL COMPLETION APPROVED BY D. TAYLOR, KDHE-BOW
4	12.5	RED BN CLAYEY SAND-SANDY CLAY, SL HARD, DRY, V FAINT ODOR			
12.5	16	LT BN-PALE GN SANDY CLAY-CLAYEY SAND, MOTTLED, SL HARD, DRY			
16	20	PALE RED BN CLAYEY SAND, FINE GRAINED, DRY-SL MOIST, FAINT O			
20	30	BN SILTY SAND, FINE GRAINED; BLACK BANDING, SL ODOR, WET @ 20'			

7 CONTRACTOR'S OR LANDOWNER'S CERTIFICATION: This water well was (1) constructed, (2) reconstructed, or (3) plugged under my jurisdiction and was completed on (mo/day/year) 7/24/03 and this record is true to the best of my knowledge and belief. Kansas Water Well Contractor's Licence No. 142 This Water Well Record was completed on (mo/day/yr) 7/24/03 under the business name of QUAD STATE SERVICES, INC. by (signature)

INSTRUCTIONS: Use typewriter or ball point pen. *PLEASE PRESS FIRMLY* and *PRINT* clearly. Please fill in blanks, underline or circle the correct answers. Send top three copies to Kansas Department of Health and Environment, Bureau of Water, Geology Section, 1000 SW Jackson St., Suite 420, Topeka, Kansas 66612-1367. Telephone 785-296-5522. Send one to WATER WELL OWNER and retain one for your records. Fee of $5.00 for each constructed well.