

LOCATION OF WATER WELL
 County: **STAFFORD** Fraction **NE 1/4 SE 1/4 SW 1/4** Section Number **3** Township Number **T 22 S** Range Number **R 12 EW**

Distance and direction from nearest town or city? **8 1/4 E 3/4 S OF SEWARD, KS** Street address of well if located within city?

WATER WELL OWNER: **Brandt Drilling Company**
 R#, St. Address, Box #: **Suite 1104 Douglas Bldg.**
 City, State, ZIP Code: **Wichita, Kansas 67202**
 Board of Agriculture, Division of Water Resources
 Application Number:

DEPTH OF COMPLETED WELL: **100** ft. Bore Hole Diameter: **10** in. to ft., and in. to ft.

Well Water to be used as:
 1 Domestic 3 Feedlot **6** Oil field water supply 8 Air conditioning 11 Injection well
 2 Irrigation 4 Industrial 7 Lawn and garden only 9 Dewatering 12 Other (Specify below)
 10 Observation well
 Well's static water level: **15** ft. below land surface measured on **AUG** month **6** day **80** year
 Pump Test Data: Well water was ft. after hours pumping. gpm
 Test Yield: **80** gpm: Well water was ft. after hours pumping gpm


TYPE OF BLANK CASING USED:
 1 Steel **3** RMP (SR) 5 Wrought iron 8 Concrete tile Casing Joints: Glued **X** Clamped
 2 PVC 4 ABS 6 Asbestos-Cement 9 Other (specify below) Welded
 7 Fiberglass Threaded
 Blank casing dia: **5** in. to ft., Dia in. to ft., Dia in. to ft.
 Casing height above land surface: **12** in., weight lbs./ft. Wall thickness or gauge No: **.214**

TYPE OF SCREEN OR PERFORATION MATERIAL:
 1 Steel 3 Stainless steel 5 Fiberglass **8** RMP (SR) 10 Asbestos-cement
 2 Brass 4 Galvanized steel 6 Concrete tile 9 ABS 12 None used (open hole)
 Screen or Perforation Openings Are:
 1 Continuous slot 3 Mill slot 5 Gauzed wrapped **8** Saw cut 11 None (open hole)
 2 Louvered shutter 4 Key punched 6 Wire wrapped 9 Drilled holes
 7 Torch cut 10 Other (specify)
 Screen-Perforation Dia: **5** in. to ft., Dia in. to ft., Dia in. to ft.
 Screen-Perforated Intervals: From **80** ft. to **100** ft., From ft. to ft., From ft. to ft.
 Gravel Pack Intervals: From ft. to ft., From ft. to ft., From ft. to ft.

GROUT MATERIAL: **1** Neat cement 2 Cement grout 3 Bentonite 4 Other
 Grouted Intervals: From **0** ft. to **10** ft., From ft. to ft., From ft. to ft.

What is the nearest source of possible contamination:
 1 Septic tank 4 Cess pool 7 Sewage lagoon 10 Fuel storage 14 Abandoned water well
 2 Sewer lines 5 Seepage pit 8 Feed yard 11 Fertilizer storage 15 Oil well/Gas well
 3 Lateral lines 6 Pit privy 9 Livestock pens 12 Insecticide storage 16 Other (specify below) **NONE**
 13 Watertight sewer lines
 Direction from well How many feet ? Water Well Disinfected? Yes **X** No
 Has a chemical/bacteriological sample submitted to Department? Yes No **X** If yes, date sample
 was submitted month day year: Pump Installed? Yes No **X**
 Yes: Pump Manufacturer's name Model No. HP Volts
 Depth of Pump Intake ft. Pumps Capacity rated at gal./min.
 Type of pump: 1 Submersible 2 Turbine 3 Jet 4 Centrifugal 5 Reciprocating 6 Other

CONTRACTOR'S OR LANDOWNER'S CERTIFICATION: This water well was **1** constructed, (2) reconstructed, or (3) plugged under my jurisdiction and was
 completed on **AUG** month **6** day **80** year
 and this record is true to the best of my knowledge and belief. Kansas Water Well Contractor's License No. **325**
 This Water Well Record was completed on **JUNE** month **24** day **81** year under the business
 name of **Central Well & Pump Inc. Pratt, Kansas** by (signature) *John Romick*

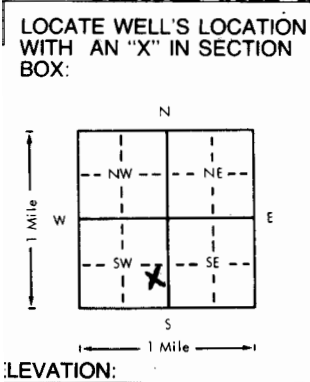

FROM	TO	LITHOLOGIC LOG	FROM	TO	LITHOLOGIC LOG
0	2	Top soil	80	90	Sand, fine to med and fine gravel
2	10	Sand, brown			
10	20	Clay, brown	90	105	Sand, med to coarse and med gravel
20	25	Sand, fine to med			
25	30	Clay, brown and white			
30	45	Sand, fine			
45	55	Clay, brown			
55	65	Clay, white			
65	75	Clay, brown with fine sand streaks			
75	80	Clay, white			

Depth(s) Groundwater Encountered 1. **20** ft. 2. ft. 3. ft. 4. ft. (Use a second sheet if needed)

INSTRUCTIONS: Use typewriter or ball point pen, please press firmly and PRINT clearly. Please fill in blanks, underline or circle the correct answers. Send top three copies to Kansas Department of Health and Environment, Division of Environment, Water Well Contractors, Topeka, KS 66620. Send one to WATER WELL OWNER and retain one for your records.

OFFICE USE ONLY
T 22
R 12
EWD
SEC 3
1/4 SE 1/4 SW 1/4