

22031

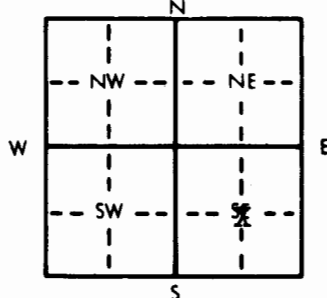
LOCATION OF WATER WELL: County: Stafford	Fraction C $\frac{1}{4}$ SE $\frac{1}{4}$	Section Number 13	Township Number T 21 S	Range Number R 12W EW
--	--	-----------------------------	----------------------------------	---------------------------------

Distance and direction from nearest town or city street address of well if located within city?

4 E, 2 N of Hudson, Kansas

WATER WELL OWNER: Leonard Kasselman Duke Drilling	Kasselman #2
IR#, St. Address, Box #: Ellinwood, Kansas Box 823	Board of Agriculture, Division of Water Resources
City, State, ZIP Code: 67526 Great Bend, Kansas 67530	Application Number: T87-80

LOCATE WELL'S LOCATION WITH AN "X" IN SECTION BOX:



WELL WATER TO BE USED AS: 5 Public water supply 8 Air conditioning 11 Injection well

1 Domestic 3 Feedlot 6 Oil field water supply 9 Dewatering 12 Other (Specify below)

2 Irrigation 4 Industrial 7 Lawn and garden only 10 Observation well

Was a chemical/bacteriological sample submitted to Department? Yes **No**; If yes, mo/day/yr sample was submittedWater Well Disinfected? Yes **No**

TYPE OF BLANK CASING USED:


TYPE OF SCREEN OR PERFORATION MATERIAL:

1 Steel 3 Stainless steel 5 Fiberglass 8 RMP (SR) 10 Asbestos-cement

2 Brass 4 Galvanized steel 6 Concrete tile 9 ABS 11 Other (specify)

SCREEN OR PERFORATION OPENINGS ARE:

1 Continuous slot 3 Mill slot 5 Gauzed wrapped 8 Saw cut 11 None (open hole)

2 Louvered shutter 4 Key punched 6 Wire wrapped 9 Drilled holes



What is the nearest source of possible contamination:

1 Septic tank 4 Lateral lines 7 Pit privy 10 Livestock pens 14 Abandoned water well

2 Sewer lines 5 Cess pool 8 Sewage lagoon 11 Fuel storage 15 Oil well/Gas well

3 Watertight sewer lines 6 Seepage pit 9 Feedyard 12 Fertilizer storage 16 Other (specify below)

Direction from well? **South** How many feet? **60**

FROM TO LITHOLOGIC LOG FROM TO LITHOLOGIC LOG

0 **90** **Sandy Clay****90** **110** **Sand and Gravel**