USE TYPEWRITER OR BALL POINT PEN-PRESS FIRMLY, PRINT CLEARLY.

WATER WELL RECORD
KSA 82a-1201-1215

Kansas Department of Health and Environment-Division of Environment
(Water well Contractors)
Topeka, Kansas 66620

1. Location of well:	County	Fraction	Section number	Township number	Range number
	Stafford	SW 1/4 SW 1/4 SE 1/4	25	T 22 S	R 12W E/W

2. Distance and direction from nearest town or city: 4e
Street address of well location if in city: Hudson, Ks.

3. Owner of well: Orlin Heyen
R.R. or street: R3 Stafford, Ks.
City, state, zip code:

4. Locate with "X" in section below:

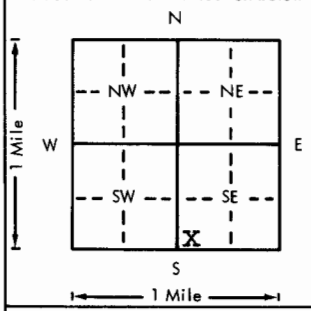

Sketch map:

5. Type and color of material	From	To
Top Soil-Clay	0	15
Sandy Clay	15	25
Sand fine	25	50

(Use a second sheet if needed)

6. Bore hole dia. 30 in. Completion date 11-16-77
Well depth 50 ft.

7. __ Cable tool __ Rotary __ Driven __ Dug
__ Hollow rod __ Jetted __ Bored X Reverse rotary

8. Use: __ Domestic __ Public supply __ Industry
X Irrigation __ Air conditioning __ Stock
__ Lawn __ Oil field water __ Other

9. Casing: Material Stl Height: Above ~~Below~~
Threaded ___ Welded ___ Surface 18 in.
RMP ___ PVC ___ Weight ___ lbs./ft.
Dia. 16 in. to 30 ft. depth Wall Thickness: inches or
Dia. ___ in. to ___ ft. depth gage No. 3/16"

10. Screw: Manufacturer's name Doerr
Type Steel Dia. 16"
Slot/gauze 1/6" Length 20'
Set between 30 ft. and 50 ft.
___ ft. and ___ ft.
Gravel pack? X Size/range of material 1/8-3/4"

11. Static water level: mo./day/yr.
15 ft. below land surface Date 11-16-77

12. Pumping level below land surfaces:
40 ft. after 4 hrs. pumping 150 g.p.m.
___ ft. after ___ hrs. pumping ___ g.p.m.
Estimated maximum yield 150 g.p.m.

13. Water sample submitted: mo./day/yr.
___ Yes X No Date

14. Well head completion:
___ Pitless adapter 18 Inches above grade

15. Well grouted? X
With: ___ Neat cement ___ Bentonite X Concrete
Depth: From 0 ft. to 10 ft.

16. Nearest source of possible contamination:
ft. 280 Direction S Type sewer
Well disinfected upon completion? ___ Yes X No

17. Pump: X Not installed
Manufacturer's name
Model number HP Volts
Length of drop pipe ft. capacity g.p.m.
Type:
___ Submersible ___ Turbine
___ Jet ___ Reciprocating
___ Centrifugal ___ Other

T 22 R 12 (W) Sec 25 1/4 SW 1/4 SW 1/4 SE

18. Elevation:

Topography:
___ Hill
___ Slope
X Upland
___ Valley

19. Remarks:

20. Water well contractor's certification:
This well was drilled under my jurisdiction and this report is true to the best of my knowledge and belief.
Kellys Waterwell Ser 186
Business name License No.
Address R2 Great Bend, Ks.
Signed Kelly Price Date 8-13-79
Authorized representative

Forward the white, blue and pink copies to the Department of Health and Environment

Form WWC-5

MI-1023