


LOCATION OF WATER WELL: County: <b>Stafford</b>	Fraction <b>SE 1/4 SE 1/4 SE 1/4</b>	Section Number <b>16</b>	Township Number <b>T 22 S</b>	Range Number <b>R 13W E/W</b>
--	---	-----------------------------	----------------------------------	----------------------------------

Distance and direction from nearest town or city street address of well if located within city?

1/2 W, 2 N of Hudson, Kansas

WATER WELL OWNER: <b>Harold Curtis Williamson Drilling</b>	<b>Curtis No. 1</b>
RR#, St. Address, Box #: <b>Route 3 5501 Navajo</b>	Board of Agriculture, Division of Water Resources
City, State, ZIP Code: <b>Hudson, Ks. 67545 Great Bend, Kansas 67530</b>	Application Number: <b>Unknown</b>

LOCATE WELL'S LOCATION WITH AN "X" IN SECTION BOX:

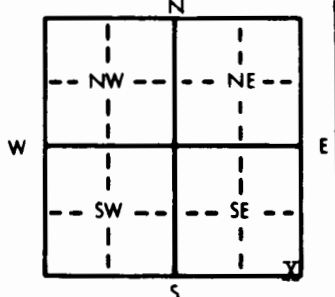

DEPTH OF COMPLETED WELL: <b>80</b> ft.	ELEVATION: <b>Unknown</b>
Depth(s) Groundwater Encountered: <b>1.20</b> ft.	
WELL'S STATIC WATER LEVEL: <b>20</b> ft. below land surface measured on mo/day/yr <b>5/6/85</b>	
Pump test data: Well water was _____ ft. after _____ hours pumping _____ gpm	
Est. Yield: <b>60</b> gpm; Well water was _____ ft. after _____ hours pumping _____ gpm	
Bore Hole Diameter: <b>8</b> in. to <b>80</b> ft., and _____ in. to _____ ft.	
WELL WATER TO BE USED AS:	
1 Domestic	3 Feedlot
2 Irrigation	4 Industrial
5 Public water supply	6 <u>Oil field water supply</u>
7 Lawn and garden only	8 Air conditioning
9 Dewatering	10 Observation well
11 Injection well	12 Other (Specify below)
Was a chemical/bacteriological sample submitted to Department? Yes <u>No</u> ; If yes, mo/day/yr sample was submitted	
Water Well Disinfected? Yes <u>No</u>	

TYPE OF BLANK CASING USED:	5 Wrought iron	8 Concrete tile	CASING JOINTS: <u>Glued</u>
1 Steel	3 RMP (SR)	6 Asbestos-Cement	9 Other (specify below)
2 <u>PVC</u>	4 ABS	7 Fiberglass	10 Asbestos-cement
Blank casing diameter: <u>5</u> in. to <u>60</u> ft., Dia _____ in. to _____ ft., Dia _____ in. to _____ ft.			
Casing height above land surface: <u>12</u> in., weight <u>2.8</u> lbs./ft. Wall thickness or gauge No. <u>Sch. 40</u>			

TYPE OF SCREEN OR PERFORATION MATERIAL:	7 <u>PVC</u>	10 Asbestos-cement
1 Steel	3 Stainless steel	5 Fiberglass
2 Brass	4 Galvanized steel	6 Concrete tile
3 Screen or perforation openings are:	5 Gauzed wrapped	8 <u>Saw cut</u>
1 Continuous slot	3 Mill slot	6 Wire wrapped
2 Louvered shutter	4 Key punched	7 Torch cut
		8 RMP (SR)
		9 ABS
		10 Other (specify)
		11 Other (specify)
		12 None used (open hole)
		13 None (open hole)

SCREEN-PERFORATED INTERVALS:	From <u>60</u> ft. to <u>80</u> ft.	From _____ ft. to _____ ft.
GRAVEL PACK INTERVALS:	From <u>10</u> ft. to <u>80</u> ft.	From _____ ft. to _____ ft.

GROUT MATERIAL:	1 <u>Neat cement</u>	2 Cement grout	3 Bentonite	4 Other
Grout Intervals: From <u>0</u> ft. to <u>10</u> ft., From _____ ft. to _____ ft., From _____ ft. to _____ ft.				
What is the nearest source of possible contamination:	1 Septic tank	4 Lateral lines	7 Pit privy	10 Livestock pens
	2 Sewer lines	5 Cess pool	8 Sewage lagoon	11 Fuel storage
	3 Watertight sewer lines	6 Seepage pit	9 Feedyard	12 Fertilizer storage
				13 Insecticide storage
				14 Abandoned water well
				15 <u>Oil well/Gas well</u>
				16 Other (specify below)
Direction from well? <u>South</u>				How many feet? <u>60</u>

FROM	TO	LITHOLOGIC LOG	FROM	TO	LITHOLOGIC LOG
0	35	Clay			
35	80	Sand and Gravel			

CONTRACTOR'S OR LANDOWNER'S CERTIFICATION: This water well was (1) constructed, (2) reconstructed, or (3) plugged under my jurisdiction and was completed on (mo/day/year) 5/6/85 and this record is true to the best of my knowledge and belief. Kansas Water Well Contractor's License No. 186. This Water Well Record was completed on (mo/day/yr) 6/9/85 under the business name of Kelly's Water Well Service by (signature) [Signature]

INSTRUCTIONS: Use typewriter or ball point pen, PLEASE PRESS FIRMLY and PRINT clearly. Please fill in blanks, underline or circle the correct answers. Send top three copies to Kansas Department of Health and Environment, Division of Environment, Environmental Geology Section, Topeka, KS 66620. Send one to WATER WELL OWNER and retain one for your records.