USE TYPEWRITER OR BALL POINT PEN-PRESS FIRMLY, PRINT CLEARLY.

WATER WELL RECORD
KSA 82a-1201-1215

Kansas Department of Health and Environment-Division of Environment
(Water well Contractors)
Topeka, Kansas 66620

| 1. Location of well: | County | Fraction | Section number | Township number | Range number |
|---|---|---|---|---|---|
| | Stafford | 1/4 NE 1/4 SW 1/4 | 20 | T 22 S | R 13 E (W) |

2. Distance and direction from nearest town or city:
8 miles North of St. John, KS
Street address of well location if in city:

3. Owner of well: G & M Feedlot, Inc.
R.R. or street: Route 3
City, state, zip code: St. John, KS 67576

4. Locate with "X" in section below: Sketch map:

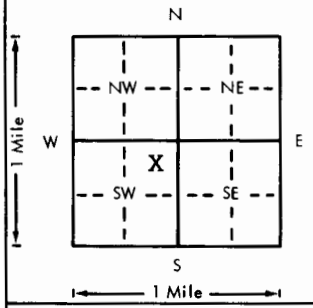


6. Bore hole dia. 9 in. Completion date 6-13-78
Well depth 80 ft. Pump Set 6-17-78

7. __ Cable tool X Rotary __ Driven __ Dug
__ Hollow rod __ Jetted __ Bored __ Reverse rotary

8. Use: __ Domestic __ Public supply __ Industry
__ Irrigation __ Air conditioning X Stock
__ Lawn __ Oil field water __ Other

9. Casing: Material Styrene Weight: Above or below
Threaded __ Welded X Surface 12 in.
RMP __ PVC __ Weight 1.5 lbs./ft.
Dia. XX 5 in. to 60 ft. depth Wall Thickness: inches or
Dia. __ in. to __ ft. depth gage No. 200

| 5. Type and color of material | From | To |
|---|---|---|
| Top soil | 0 | 3 |
| Brown clay & limestone | 3 | 50 |
| Sand & gravel & clay streaks | 50 | 58 |
| Sand & gravel | 58 | 80 |
| | | |
| | | |
| | | |
| | | |
| | | |
| | | |
| | | |
| | | |
| | | |
| | | |
| (Use a second sheet if needed) | | |

10. Screen: Manufacturer's name Jess & Lowell Styrene 200
Type XXXXXXXXXX Dia. 5"
Slot gauze 1/8" Length 20'
Set between 60 ft. and 80 ft.
ft. and ft.
Gravel pack? Yes Size range of material 3/8-200

11. Static water level: mo./day/yr.
20 ft. below land surface Date 6-13-78

12. Pumping level below land surfaces: Not Checked
ft. after hrs. pumping g.p.m.
ft. after hrs. pumping g.p.m.
Estimated maximum yield g.p.m.

13. Water sample submitted: mo./day/yr.
__ Yes X No Date

14. Well head completion:
__ Pitless adapter 12 Inches above grade

15. Well grouted? Yes
With: X Neat cement __ Bentonite __ Concrete
Depth: From 0 ft. to 10 ft.

16. Nearest source of possible contamination: FIELD
ft. Direction Type
Well disinfected upon completion? X Yes __ No

17. Pump: __ Not installed
Manufacturer's name Berkeley Pump Co.
Model number 4CM-15 HP 5 Volts 460
Length of drop pipe 44 ft. capacity 60 g.p.m.
Type:
X Submersible __ Turbine
__ Jet __ Reciprocating
__ Centrifugal __ Other

18. Elevation:

Topography:
__ Hill
__ Slope
__ Upland
__ Valley

19. Remarks:

20. Water well contractor's certification:
This well was drilled under my jurisdiction and this report is true to the best of my knowledge and belief.
Clarke Well & Eq., Inc. 185
Business name License No.
Address Great Bend, KS 67530
Signed [signature] Date 6-29-78
Authorized representative

T 22 R 13 (W) E Sec 20 1/4 1/4 1/4 NESW

Forward the white, blue and pink copies to the Department of Health and Environment

Form WWC-5

MI-1023