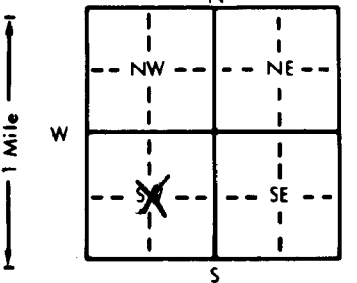


1 LOCATION OF WATER WELL:		Fraction	Section Number	Township Number	Range Number
County: <u>Stafford</u>		$\frac{1}{4}$ <u>N/C</u> $\frac{1}{4}$ <u>SW</u> $\frac{1}{4}$	<u>36</u>	<u>T 22 S</u>	<u>R 14 E/W</u>
Distance and direction from nearest town or city street address of well if located within city? <u>5 3/4 south 3/4 west of Seward, Kansas</u>					
2 WATER WELL OWNER:		Board of Agriculture, Division of Water Resources			
RR#, St. Address, Box # : <u>504 N. Exchange</u>		Application Number: <u>10,269</u>			
City, State, ZIP Code : <u>St. John, Ks. 67576</u>					
3 LOCATE WELL'S LOCATION WITH AN "X" IN SECTION BOX:		4 DEPTH OF COMPLETED WELL <u>136</u> ft. ELEVATION:			
		Depth(s) Groundwater Encountered 1. ft. 2. ft. 3. ft.			
		WELL'S STATIC WATER LEVEL ... <u>22</u> ... ft. below land surface measured on mo/day/yr <u>11-8-99</u>			
		Pump test data: Well water was ... <u>61 1/2</u> ... ft. after ... <u>2</u> ... hours pumping ... <u>900</u> ... gpm			
		Est. Yield ... <u>1200</u> ... gpm: Well water was ... <u>73</u> ... ft. after ... <u>4</u> ... hours pumping ... <u>1200</u> ... gpm			
		Bore Hole Diameter ... <u>28</u> ... in. to ... <u>135</u> ... ft., and ... in. to ... ft.			
WELL WATER TO BE USED AS:		5 Public water supply 8 Air conditioning 11 Injection well			
1 Domestic 3 Feedlot 6 Oil field water supply 9 Dewatering 12 Other (Specify below)					
2 Irrigation 4 Industrial 7 Lawn and garden only 10 Monitoring well					
Was a chemical/bacteriological sample submitted to Department? Yes.....No... <u>X</u>; If yes, mo/day/yr sample was submitted		Water Well Disinfected? Yes No <u>X</u>			
5 TYPE OF BLANK CASING USED:		5 Wrought iron 8 Concrete tile		CASING JOINTS: Glued <u>X</u> Clamped	
1 Steel 3 RMP (SR)		6 Asbestos-Cement 9 Other (specify below)		Welded	
2 PVC 4 ABS		7 Fiberglass		Threaded	
Blank casing diameter ... <u>16</u> ... in. to ... <u>76</u> ... ft., Dia ... in. to ... ft., Dia ... in. to ... ft.					
Casing height above land surface ... <u>12</u> ... in., weight ... <u>Sch. 40</u> ... lbs./ft. Wall thickness or gauge No.					
TYPE OF SCREEN OR PERFORATION MATERIAL:		7 PVC 10 Asbestos-cement			
1 Steel 3 Stainless steel 5 Fiberglass 8 RMP (SR) 11 Other (specify)					
2 Brass 4 Galvanized steel 6 Concrete tile 9 ABS 12 None used (open hole)					
SCREEN OR PERFORATION OPENINGS ARE:		5 Gauzed wrapped 8 Saw cut 11 None (open hole)			
1 Continuous slot 3 Mill slot 6 Wire wrapped 9 Drilled holes					
2 Louvered shutter 4 Key punched 7 Torch cut 10 Other (specify)					
SCREEN-PERFORATED INTERVALS:		From ... <u>136</u> ... ft. to ... <u>76</u> ... ft., From ... ft. to ... ft.			
GRAVEL PACK INTERVALS:		From ... <u>136</u> ... ft. to ... <u>20</u> ... ft., From ... ft. to ... ft.			
From ... ft. to ... ft.		From ... ft. to ... ft.			

6 GROUT MATERIAL:		1 Neat cement 2 Cement grout 3 Bentonite 4 Other .. <u>Hole plug</u>	
Grout Intervals: From ... <u>20</u> ... ft. to ... <u>0</u> ... ft., From ... ft. to ... ft.			
What is the nearest source of possible contamination:		10 Livestock pens 14 Abandoned water well	
1 Septic tank 4 Lateral lines 7 Pit privy 11 Fuel storage 15 Oil well/Gas well			
2 Sewer lines 5 Cess pool 8 Sewage lagoon 12 Fertilizer storage 16 Other (specify below)			
3 Watertight sewer lines 6 Seepage pit 9 Feedyard 13 Insecticide storage .. <u>NONE</u>			
Direction from well?		How many feet?	

FROM	TO	LITHOLOGIC LOG	FROM	TO	PLUGGING INTERVALS
0	3	Sandy top soil			
3	15	Brown clay			
15	18	Gray clay			
18	31	Sandy brown clay			
31	38	Gray clay			
38	46	Sand & gravel-fine to medium some clay			
46	64	Sand & gravel clean, coarse, loose			
64	79	Reddish brown & white clay			
79	97	Sand & gravel medium loose clean			
97	99	Blue green clay			
99	109	Fine sand & gray green clay mixed			
109	118	Sand & clay mixed			
118	136	Sand & gravel clean, loose, medium			

7 CONTRACTOR'S OR LANDOWNER'S CERTIFICATION: This water well was (1) constructed, (2) reconstructed, or (3) plugged under my jurisdiction and was completed on (mo/day/year) ... <u>3-28-00</u> ... and this record is true to the best of my knowledge and belief. Kansas Water Well Contractor's License No. ... <u>134</u> ... This Water Well Record was completed on (mo/day/yr) ... <u>3-29-00</u> ... under the business name of <u>Rosencrantz-Bemis</u> by (signature) <u>Freddie Dedson</u>	
---	--