

1	LOCATION OF WATER WELL:	Fraction	Section Number	Township Number	Range Number
County: <u>Stafford</u>		<u>NE ¼</u> <u>NE ¼</u> <u>SE ¼</u>	<u>7</u>	<u>T 22 S</u>	<u>R 14 E/W</u>

Distance and direction from nearest town or city street address of well if located within city?

From Radium, 1 1/2 S, West into

2	WATER WELL OWNER: Bob Standish
---	--------------------------------


RR#, St. Address, Box # : RR3- Box 7774B
City, State, ZIP Code : Seward, Ks. 67576

Board of Agriculture, Division of Water Resources

Application Number: SFWW 2340

3	LOCATE WELL'S LOCATION WITH	4	DEPTH OF COMPLETED WELL <u>76</u> ft. ELEVATION:
---	-----------------------------	---	--

AN "X" IN SECTION BOX:

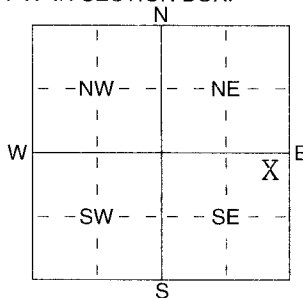

Depth(s) Groundwater Encountered 1 ft. 2 ft. 3 ft.

WELL'S STATIC WATER LEVEL 25 ft. below land surface measured on mo/day/yr 8-12-02

Pump test data: Well water was ft. after hours pumping gpm

Est. Yield NA gpm: Well water was ft. after hours pumping gpm

WELL WATER TO BE USED AS: 5 Public water supply 8 Air conditioning 11 Injection well

1 Domestic 3 Feedlot 6 Oil field water supply 9 Dewatering 12 Other (Specify below)

2 Irrigation 4 Industrial 7 Domestic (lawn & garden) 10 Monitoring well Stock Well

Was a chemical/bacteriological sample submitted to Department? Yes No X; If yes, mo/day/yr sample was submitted
Water Well Disinfected? Yes HTH No

Water Well Disinfected? Yes HTH No

5	TYPE OF BLANK CASING USED:
---	----------------------------

1 Steel	3 RMP (SR)
2 PVC	4 ABS

ank casing diameter 5 in. to 56 ft. Dia 0 in. to _____ ft. Dia _____ in. to _____ ft.

Casing height above land surface 24 in., weight SDR- 26 lbs./ft. Wall thickness or guage No.

TYPE OF SCREEN OR PERFORATION MATERIAL:

1 Steel	3 Stainless Steel	5 Fiberglass	8 <u>RMP (SR)</u>	11 Other (Specify)
2 Brass	4 Galvanized Steel	6 Concrete tile	9 ABS	12 None used (open hole)

SCREEN OR PERFORATION OPENINGS ARE:

1 Continuous slot	3 Mill slot	6 Wire wrapped	9 Drilled holes
2 Louvered shutter	4 Kev punched	7 Torch cut	10 Other (specify)

SCREEN-PERFORATED INTERVALS: From 76 ft. to 56 ft., From _____ ft. to _____ ft.

GRAVEL PACK INTERVALS:

From	76	ft. to	44	ft., From		ft. to		ft.
From	41	ft. to	20	ft., From		ft. to		ft.

6	GROUT MATERIAL:	1 Neat cement	2 Cement grout	3 Bentonite	4 Other <u>hole plug</u>
---	-----------------	---------------	----------------	-------------	--------------------------

Grout Intervals: From 44 ft. to 41 ft., From 20 ft. to 2 ft., From _____ ft. to _____ ft.

What is the nearest source of possible contamination:

1 Septic tank	4 Lateral lines	7 Pit privy	11 Fuel storage	15 Oil well/Gas well
2 Sewer lines	5 Cess pool	8 Sewage lagoon	12 Fertilizer storage	16 Other (specify below)
3 Watertight sewer lines	6 Seepage pit	9 Feedyard	13 Insecticide storage	Machine Shed

Direction from well? North How many feet? 50

How many feet? 50

[illegible]

7. CONTRACTOR'S OR LANDOWNER'S CERTIFICATION: This water well was (1) constructed, (2) reconstructed, or (3) plugged under my jurisdiction and was completed on (mo/day/year) 8-29-02 and this record is true to the best of my knowledge and belief. Kansas

Water Well Contractor's Licence No. 134 This Water Well Record was completed on (mo/day/yr) 9-4-02

under the business name of Rosencrantz- Bemis

by (signature) *[Signature]*