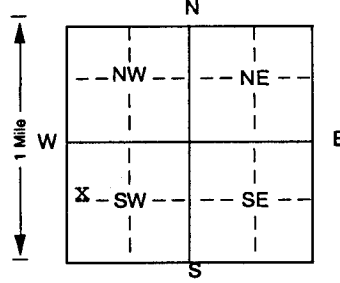


1 LOCATION OF WATER WELL:		Fraction		Section Number		Township Number		Range Number	
County: Stafford		SW 1/4 NW 1/4 SW 1/4		3		T 22 S		R 14 E (W)	
Distance and direction from nearest town or city street address of well if located within city?									
From Seward go 3 1/2 miles west and 1/4 mile north									
2 WATER WELL OWNER: John Dewerff									
RR#, St. Address, Box #: 941 SE 50 Road									
City, State, ZIP Code: Ellinwood, KS 67526									
Board of Agriculture, Division of Water Resources									
Application Number:									
3 LOCATE WELL'S LOCATION WITH AN "X" IN SECTION BOX:		4 DEPTH OF COMPLETED WELL 80 ft. ELEVATION:							
		Depth(s) Groundwater Encountered 1 ft. 2 ft. 3 ft.							
		WELL'S STATIC WATER LEVEL 33.94 ft. below land surface measured on mo/day/yr 12-1-03							
		Pump test data: Well water was ft. after hours pumping gpm							
		Est. Yield gpm: Well water was ft. after hours pumping gpm							
		Bore Hole Diameter 8 in. to 80 ft., and in. to ft.							
		WELL WATER TO BE USED AS: 5 Public water supply 8 Air conditioning 11 Injection well							
		1 Domestic 3 Feedlot 6 Oil field water supply 9 Dewatering (12) Other (specify below)							
		2 Irrigation 4 Industrial 7 Domestic (lawn & garden) 10 Monitoring well Stock Well							
		Was a chemical/bacteriological sample submitted to Department? Yes No (checked) If yes, mo/day/yr sample was submitted							
		Water Well Disinfected? Yes No (checked)							
5 TYPE OF BLANK CASING USED:									
1 Steel 3 RMP (SR) 5 Wrought iron 8 Concrete tile CASING JOINTS: Glued Clamped									
(2) PVC 4 ABS 6 Asbestos-Cement 9 Other (specify below) Welded									
7 Fiberglass Threaded									
Blank casing diameter 5 in. to 68 ft., Dia in. to ft., Dia in. to ft.									
Casing height above land surface 24 in., weight 2.36 lbs./ft. Wall thickness or gauge No .214									
TYPE OF SCREEN OR PERFORATION MATERIAL: (7) PVC 10 Asbestos-cement									
1 Steel 3 Stainless steel 5 Fiberglass 8 RMP (SR) 11 Other (specify)									
2 Brass 4 Galvanized steel 6 Concrete tile 9 ABS 12 None used (open hole)									
SCREEN OR PERFORATION OPENINGS ARE: 5 Gauzed wrapped 8 Saw cut 11 None (open hole)									
1 Continuous slot (3) Mill slot 6 Wire wrapped 9 Drilled holes									
2 Louvered shutter 4 Key punched 7 Torch cut 10 Other (specify) ft.									
SCREEN-PERFORATED INTERVALS: From 68 ft. to 78 ft., From ft. to ft.									
GRAVEL PACK INTERVALS: From 60 ft. to 80 ft., From ft. to ft.									
From ft. to ft., From ft. to ft.									
6 GROUT MATERIAL: 1 Neat cement 2 Cement grout 3 Bentonite 4 Other Bentonite Holeplug									
Grout Intervals: From 0 ft. to 20 ft., From ft. to ft., From ft. to ft.									
What is the nearest source of possible contamination:									
1 Septic tank 4 Lateral lines 7 Pit privy 10 Livestock pens 14 Abandoned water well									
2 Sewer lines 5 Cess pool 8 Sewage lagoon 11 Fuel storage 15 Oil well/Gas well									
3 Watertight sewer lines 6 Seepage pit 9 Feedyard 12 Fertilizer storage 16 Other (specify below)									
13 Insecticide storage none known									
Direction from well? How many feet?									
FROM TO LITHOLOGIC LOG FROM TO PLUGGING INTERVALS									
0 5 Topsoil									
5 12 Clay, brown, sandy									
12 23 Clay, white, hard									
23 36 Clay, brown									
36 57 Sand and gravel, medium to fine									
57 58 Clay, brown									
58 80 Sand and gravel, coarse to fine									
7 CONTRACTOR'S OR LANDOWNER'S CERTIFICATION: This water well was (1) constructed (2) reconstructed, or (3) plugged under my jurisdiction and was completed on (mo/day/year) 12-1-03 and this record is true to the best of my knowledge and belief. Kansas									
Water Well Contractor's License No 185 This Water Well Record was completed on (mo/day/yr) 12-3-03									
under the business name of Clarke Well & Equipment, Inc. by (signature) [Signature]									