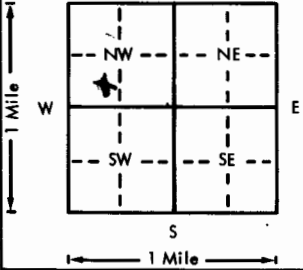


USE TYPEWRITER OR BALL
POINT PEN-PRESS FIRMLY,
PRINT CLEARLY.

WATER WELL RECORD
KSA 82a-1201-1215

Kansas Department of Health and
Environment-Division of Environment
(Water well Contractors)
Topeka, Kansas 66620

1. Location of well:		County <u>Stafford</u>	Fraction <u>SE 1/4 SW 1/4 T10N 1/4</u>	Section number <u>5</u>	Township number <u>T 22N</u>	Range number <u>S R 14E</u>
2. Distance and direction from nearest town or city: <u>1/4 mile South east Radburn to</u>		3. Owner of well: <u>Duke Drilling Co.</u>				
Street address of well location if in city:		R.R. or street: <u>great Bend Turnpike</u>				
City, state, zip code: <u>great Bend Kansas</u>						
4. Locate with "X" in section below:		Sketch map:				
						
5. Type and color of material		From	To	6. Bore hole dia. <u>5</u> in. Completion date <u>5-25-76</u>		
				Well depth <u>60</u> ft.		
				7. ☒ Cable tool ☒ Rotary ☐ Driven ☐ Dug		
				☐ Hollow rod ☐ Jetted ☐ Bored ☐ Reverse rotary		
				8. Use: ☐ Domestic ☐ Public supply ☐ Industry		
				☐ Irrigation ☐ Air conditioning ☐ Stock		
				☐ Lawn ☒ Oil field water ☐ Other		
				9. Casing: Material ☐ Height: Above or below, <u>13</u> in.		
				Threaded ☐ Welded ☐ Surface <u>13</u> in.		
				RMP ☐ PVC ☒ Weight <u>47.6</u> lbs./ft.		
				Dia. <u>5</u> in. to <u>60</u> ft. depth Wall Thickness: inches or		
				Dia. <u>5</u> in. to <u>60</u> ft. depth gage No. <u>154</u>		
				10. Screen: Manufacturer's name <u></u>		
				Type <u></u> Dia. <u></u>		
				Slot/gauze <u>1/4"</u> Length <u>10 ft.</u>		
				Set between <u>50</u> ft. and <u>60</u> ft.		
				<u>50</u> ft. and <u>60</u> ft.		
				Gravel pack? ☒ Size range of material <u>2-6</u>		
				11. Static water level: <u>12</u> ft. below land surface Date <u>5-25-76</u>		
				12. Pumping level below land surfaces:		
				<u>15</u> ft. after <u>1</u> hrs. pumping <u>80</u> g.p.m.		
				<u></u> ft. after <u></u> hrs. pumping <u></u> g.p.m.		
				Estimated maximum yield <u>100</u> g.p.m.		
				13. Water sample submitted: <u></u> mo./day/yr.		
				Yes ☒ No ☐ Date <u></u>		
				14. Well head completion:		
				<u></u> Pitless adapter <u>13</u> inches above grade		
				15. Well grouted? <u>Yes</u>		
				With: <u></u> Neat cement ☒ Bentonite ☐ Concrete ☐		
				Depth: From <u>0</u> ft. to <u>15</u> ft.		
				16. Nearest source of possible contamination:		
				ft. <u></u> Direction <u></u> Type <u></u>		
				Well disinfected upon completion? <u></u> Yes ☒ No ☐		
				17. Pump: ☒ Not installed		
				Manufacturer's name <u></u>		
				Model number <u></u> HP <u></u> Volts <u></u>		
				Length of drop pipe <u></u> ft. capacity <u></u> g.p.m.		
				Type:		
				☐ Submersible ☐ Turbine		
				☐ Jet ☐ Reciprocating		
				☐ Centrifugal ☐ Other		
18. Elevation: <u>1850</u>		19. Remarks:				
Topography:						
☐ Hill						
☒ Slope						
☐ Upland						
☐ Valley						
		20. Water well contractor's certification:				
		This well was drilled under my jurisdiction and this report is true to the best of my knowledge and belief.				
		Business name <u>Great Bend Turnpike</u> License No. <u>0143</u>				
		Address <u>great Bend Kansas</u>				
		Signed <u>Shirley J. Jones</u> Date <u>5-25-76</u>				
		Authorized representative				

Forward the white, blue and pink copies to the Department of Health and Environment

Form WWC-5