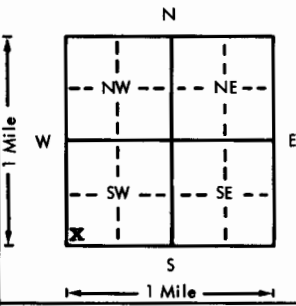


USE TYPEWRITER OR BALL POINT PEN. PRESS FIRMLY. PRINT CLEARLY.

WATER WELL RECORD
KSA 82a-1201-1215

Kansas Department of Health and Environment-Division of Environment
(Water well Contractors)
Topeka, Kansas 66620

1. Location of well:	County: Stafford	Fraction: SW 1/4 SW 1/4 SW 1/4	Section number: 5	Township number: T 22 S	Range number: R 14 EW
2. Distance and direction from nearest town or city: 6 miles Southwest of Seward, KS Street address of well location if in city:			3. Owner of well: Mildred Durant R.R. or street: (?) City, state, zip code: Radium, KS 67571		
4. Locate with "X" in section below: Sketch map: 			6. Bore hole dia. <u>9</u> in. Completion date 12-2-76 Well depth <u>50</u> ft.		
5. Type and color of material			7. <input type="checkbox"/> Cable tool <input type="checkbox"/> Rotary <input type="checkbox"/> Driven <input type="checkbox"/> Dug <input type="checkbox"/> Hollow rod <input type="checkbox"/> Jetted <input type="checkbox"/> Bored <input checked="" type="checkbox"/> Reverse rotary		
			8. Use: <input checked="" type="checkbox"/> Domestic <input type="checkbox"/> Public supply <input type="checkbox"/> Industry <input type="checkbox"/> Irrigation <input type="checkbox"/> Air conditioning <input type="checkbox"/> Stock <input type="checkbox"/> Lawn <input type="checkbox"/> Oil field water <input type="checkbox"/> Other		
			9. Casing: Material Styrene Right <input type="checkbox"/> Above <input checked="" type="checkbox"/> Below Threaded <input type="checkbox"/> Welded <input checked="" type="checkbox"/> Surface <u>12</u> in. RMP <input type="checkbox"/> PVC <input type="checkbox"/> Weight <u>1.5</u> lbs./ft. Dia. <u>5</u> in. to <u>40</u> ft. depth Wall Thickness: inches or Dia. <u> </u> in. to <u> </u> ft. depth gage No. <u>200#</u>		
			10. Screen: Manufacturer's name Jess & Lowell Type Styrene 200 Dia. <u>5"</u> Slot/auze <u>1/8"</u> Length <u>10'</u> Set between <u>40</u> ft. and <u>50</u> ft. ft. and <u> </u> ft. Gravel pack? yes Size range of material <u>3/8-200</u>		
			11. Static water level: <u>17</u> ft. below land surface Date 10-21-76 mo./day/yr.		
			12. Pumping level below land surfaces: N/C <u> </u> ft. after <u> </u> hrs. pumping <u> </u> g.p.m. <u> </u> ft. after <u> </u> hrs. pumping <u> </u> g.p.m. Estimated maximum yield <u> </u> g.p.m.		
			13. Water sample submitted: <u> </u> mo./day/yr. Yes <input type="checkbox"/> No <input checked="" type="checkbox"/> Date <u> </u>		
			14. Well head completion: <input type="checkbox"/> Pitless adapter <u>12</u> inches above grade		
			15. Well grouted? yes With: <input checked="" type="checkbox"/> Neat cement <input type="checkbox"/> Bentonite <input type="checkbox"/> Concrete Depth: From <u>0</u> ft. to <u>10</u> ft.		
			16. Nearest source of possible contamination: ft. <u> </u> Direction <u> </u> Type <u> </u> Well disinfected upon completion? <input checked="" type="checkbox"/> Yes <input type="checkbox"/> No		
			17. Pump: Not installed Manufacturer's name Berkeley Pump Co. Model number 4AM-11 HP <u>3</u> Volts 220 Length of drop pipe <u>33</u> ft. capacity <u>10</u> g.p.m. Type: <input checked="" type="checkbox"/> Submersible <input type="checkbox"/> Turbine <input type="checkbox"/> Jet <input type="checkbox"/> Reciprocating <input type="checkbox"/> Centrifugal <input type="checkbox"/> Other		
			(Use a second sheet if needed)		
18. Elevation: Topography: <input type="checkbox"/> Hill <input type="checkbox"/> Slope <input type="checkbox"/> Upland <input type="checkbox"/> Valley		19. Remarks:		20. Water well contractor's certification: This well was drilled under my jurisdiction and this report is true to the best of my knowledge and belief. Clarke Well & Eq., Inc. 185 Business name <u> </u> License No. <u> </u> Address Great Bend, KS 67530 Signed <u>D.W. Clarke</u> Date 12-8-76 Authorized representative	

22 1/4 E
1/4 SW SW SW
1/4 1/4 1/4

Forward the white, blue and pink copies to the Department of Health and Environment

Form WWC-5