USE TYPEWRITER OR BALL POINT PEN-PRESS FIRMLY, PRINT CLEARLY.

CE½ NW NW

T R EW sec 1/4 1/4 1/4 No.

WATER WELL RECORD
KSA 82a-1201-1215

Kansas State Dept. Of Health
(Water Well Contractors)
Forbes-Bldg. 740
Topeka, Kansas 66620

1 Location of well:	County	Township name	Fraction	Section number	Town number	Range number
	Stafford		CE¼ NW NW	12	22	14

Distance and direction from nearest town or city: 1 South 1 West of Seward

Street address of well location if in city:

3 Owner of well: Search Drilling Co. Wichita Ks. 250 N. Rock Rd.

Address: Williams #1

Locate with "X" in section below:

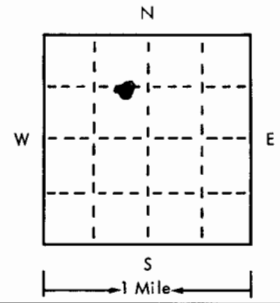

Sketch map:

4 Well depth: 70 ft. Date of completion 1-31-75
Well diameter 8 in. 5

5 ☐ Cable tool ☒ Rotary ☐ Driven ☐ Dug ☐ Hollow rod ☐ Jetted ☐ Bored ☐ Reverse rotary

6 Use: ☐ Domestic ☐ Public supply ☒ Industry ☐ Irrigation ☐ Air conditioning ☐ Commercial ☐ Test well ☒ oil field

7 Casing: Material Blastic Weight: 1½ above/below
Threaded ☐ Welded ☒ Surface 2 in.
Diam. 2 in. to 20 ft. depth Weight 47 lbs./ft. 100
Drive shoe? ☐ Yes ☒ No
— in. to — ft. depth

2 Type and color of material	From	To
Clay	0	10
Sand	10	30
Clay	30	45
Sand	45	55
Gravel	55	70
Plugged by Theodore Heiter, Route 1 Pratt, KS 67124		
Conversation with Search Drlg Co on 3/27/75 DWB		
(use a second sheet if needed)		

8 Screen:
Manufacturer John Manville
Type PVC Dia. 2
Slot/gauze .5 Length 10
Set between 60 ft. and 70 ft.
Fittings:
Gravel pack ☒ Yes ☐ No Size range of material —

9 Static water level:
14 ft. below land surface Date 1-31-75

10 Pumping level below land surfaces:
— ft. after — hrs. pumping — g.p.m.
— ft. after — hrs. pumping — g.p.m.
Estimated maximum yield — g.p.m.

11 Water sample submitted:
☐ Yes ☒ No Date —

12 Well head completion:
☒ Pitless adapter ☐ Inches above grade

13 Well grouted? ☒ Yes ☐ No
☐ Neat cement ☒ Bentonite ☐ —
Depth: From 0 ft. to 60 ft.

14 Nearest source of possible contamination:
ft. 100 Direction West Type salt water
Well disinfected upon completion? ☐ Yes ☒ No

15 Pump: ☒ Not installed
Manufacturer's name —
Model number — HP — Volts —
Length of drop pipe — ft. capacity — g.m.p.
Type:
☐ Submersible ☐ Turbine
☐ Jet ☐ Reciprocating
☐ Certrifugal ☐ Other

16 Remarks: elevation

Topography:
☐ Hill
☒ Slope
☐ Upland
☐ Valley

17 Water well contractor's certification:
This well was drilled under my jurisdiction and this report is true to the best of my knowledge and belief.
Myers Water Well Business name License No. 143
Address Great Bend Ks.
Signed David Sampson Date 1-31-75
Authorized representative

Forward the white, blue and pink copies to the Kansas State Dept. Of Health.

Form WWC-5

677-H