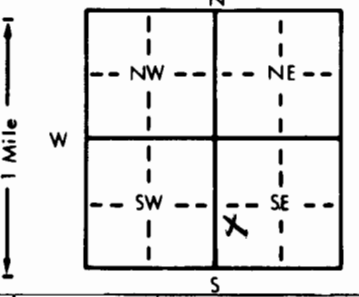


1 LOCATION OF WATER WELL:		Fraction	Section Number	Township Number	Range Number
County: <u>Stafford</u>		<u>nw</u> $\frac{1}{4}$ <u>sw</u> $\frac{1}{4}$ <u>se</u> $\frac{1}{4}$	<u>23</u>	<u>T 22 S</u>	<u>R 14 E</u>
Distance and direction from nearest town or city street address of well if located within city? <u>3 3/4 south-3 1/8 east of Radium, Ks.</u>					
2 WATER WELL OWNER: <u>Melvin Schartz</u>		Mustang Drilling			
RR#, St. Address, Box #: <u>Great Bend, Ks. 67530</u>		Box 1609 Board of Agriculture, Division of Water Resources			
City, State, ZIP Code: <u>Great Bend, Ks. 67530</u>		Application Number: <u>T84-412</u>			
3 LOCATE WELL'S LOCATION WITH AN "X" IN SECTION BOX:		4 DEPTH OF COMPLETED WELL: <u>95</u> ft. ELEVATION:			
		Depth(s) Groundwater Encountered 1. <u>27</u> ft. 2. ft. 3. ft.			
		WELL'S STATIC WATER LEVEL <u>27</u> ft. below land surface measured on mo/day/yr <u>7-17-84</u>			
		Pump test data: Well water was ft. after hours pumping gpm			
		Est. Yield <u>na.</u> gpm: Well water was ft. after hours pumping gpm			
Bore Hole Diameter: <u>10</u> in. to <u>95</u> ft., and in. to ft.		WELL WATER TO BE USED AS:			
1 Domestic		3 Feedlot	6 Oil field water supply	9 Dewatering	12 Other (Specify below)
2 Irrigation		4 Industrial	7 Lawn and garden only	10 Observation well	
Was a chemical/bacteriological sample submitted to Department? Yes.....No <u>X</u>; If yes, mo/day/yr sample was submitted					
Water Well Disinfected? Yes <u>hth</u> No					
5 TYPE OF BLANK CASING USED:		5 Wrought iron	8 Concrete tile	CASING JOINTS: <u>Glued</u> Clamped	
1 Steel		3 RMP (SR)	6 Asbestos-Cement	Welded	
2 PVC		4 ABS	7 Fiberglass	Threaded	
Blank casing diameter <u>5</u> in. to <u>95</u> ft., Dia in. to ft., Dia in. to ft.					
Casing height above land surface <u>18</u> in., weight lbs./ft. Wall thickness or gauge No. <u>258</u>					
TYPE OF SCREEN OR PERFORATION MATERIAL:		7 PVC		10 Asbestos-cement	
1 Steel		3 Stainless steel	5 Fiberglass	8 RMP (SR)	
2 Brass		4 Galvanized steel	6 Concrete tile	9 ABS	
3 Watertight sewer lines		6 Seepage pit	9 Feedyard	12 None used (open hole)	
SCREEN OR PERFORATION OPENINGS ARE:		5 Gauzed wrapped	8 Saw cut	11 None (open hole)	
1 Continuous slot		3 Mill slot	6 Wire wrapped	9 Drilled holes	
2 Louvered shutter		4 Key punched	7 Torch cut	10 Other (specify)	
SCREEN-PERFORATED INTERVALS:		From <u>75</u> ft. to <u>95</u> ft., From ft. to ft.	From ft. to ft.		
GRAVEL PACK INTERVALS:		From <u>10</u> ft. to <u>95</u> ft., From ft. to ft.	From ft. to ft.		
6 GROUT MATERIAL:		1 Neat cement	2 Cement grout	3 Bentonite	4 Other
Grout Intervals: From <u>0</u> ft. to <u>10</u> ft., From ft. to ft., From ft. to ft.					
What is the nearest source of possible contamination:		10 Livestock pens		14 Abandoned water well	
1 Septic tank		4 Lateral lines	7 Pit privy	11 Fuel storage	
2 Sewer lines		5 Cess pool	8 Sewage lagoon	12 Fertilizer storage	
3 Watertight sewer lines		6 Seepage pit	9 Feedyard	13 Insecticide storage	
Direction from well? <u>west</u>		How many feet? <u>100</u>			
FROM	TO	LITHOLOGIC LOG	FROM	TO	LITHOLOGIC LOG
0	5	Top soil			
5	13	Sandy clay			
13	27	Tan clay			
27	56	Sand and gravel			
56	59	Tan sandy clay			
59	94	Sand and gravel			
94	95	Yellow & gray clay			
7 CONTRACTOR'S OR LANDOWNER'S CERTIFICATION: This water well was (1) <u>constructed</u> , (2) reconstructed, or (3) plugged under my jurisdiction and was completed on (mo/day/year) <u>7-17-84</u> and this record is true to the best of my knowledge and belief. Kansas Water Well Contractor's License No. <u>134</u> This Water Well Record was completed on (mo/day/yr) <u>7-31-84</u> under the business name of <u>Rosencrantz-Bemis</u> by (signature) <u>Alora Dodson</u>					
INSTRUCTIONS: Use typewriter or ball point pen, PLEASE PRESS FIRMLY and PRINT clearly. Please fill in blanks, underline or circle the correct answers. Send top three copies to Kansas Department of Health and Environment, Division of Environment, Environmental Geology Section, Topeka, KS 66620. Send one to WATER WELL OWNER and retain one for your records.					