USE TYPEWRITER OR BALL POINT PEN-PRESS FIRMLY, PRINT CLEARLY.

WATER WELL RECORD
KSA 82a-1201-1215

Kansas Department of Health and Environment-Division of Environment
(Water well Contractors)
Topeka, Kansas 66620

1. Location of well: County: Stafford | Fraction: C / NE (1/4 1/4 1/4) | Section number: 27 | Township number: T 22 S | Range number: R 14 E (W)

2. Distance and direction from nearest town or city: 2 mi 4 4 S of Seward, Ks
Street address of well location if in city:

3. Owner of well: Carl Staub
R.R. or street: Rt. 3
City, state, zip code: St. John, Ks.

4. Locate with "X" in section below:

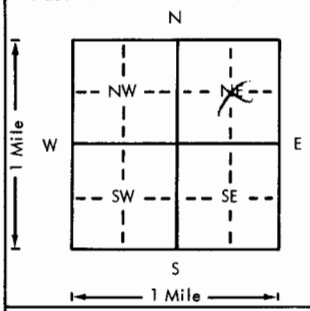

Sketch map:

6. Bore hole dia. 24 in. Completion date _____
Well depth 87 ft. 5-25-76

7. __ Cable tool ✓ Rotary __ Driven __ Dug
__ Hollow rod __ Jetted __ Bored __ Reverse rotary

8. Use: __ Domestic __ Public supply __ Industry
✓ Irrigation __ Air conditioning __ Stock
__ Lawn __ Oil field water __ Other

9. Casing: Material Steel | Height: Above or below
Threaded ___ Welded ✓ | Surface 18 in.
RMP ___ PVC ___ | Weight ___ lbs./ft.
Dia. 16 in. to 87 ft. depth | Wall Thickness: inches or
Dia. ___ in. to ___ ft. depth | gage No. 7

10. Screen: Manufacturer's name Doerrs
Type Steel Dia. 16
Slot/gauze 3/16 Length 28
Set between 59 ft. and 87 ft.
___ ft. and ___ ft.
Gravel pack? ✓ Size range of material 1/2 3/4 3/8

11. Static water level: mo./day/yr.
23 ft. below land surface Date 2-27-73

12. Pumping level below land surfaces:
16 ft. after 1 hrs. pumping 1400 g.p.m.
___ ft. after ___ hrs. pumping ___ g.p.m.
Estimated maximum yield 1400+ g.p.m.

13. Water sample submitted: mo./day/yr.
___ Yes ___ No Date 7-10-76

14. Well head completion:
___ Pitless adapter ___ Inches above grade

15. Well grouted? ✓
With: ___ Neat cement ___ Bentonite ✓ Concrete
Depth: From 0 ft. to 10 ft.

16. Nearest source of possible contamination:
ft. 3/4 m Direction N W Type Cancel
Well disinfected upon completion? ___ Yes ___ No

17. Pump: ___ Not installed
Manufacturer's name WLR
Model number 4CM6 HP 50 Volts ___
Length of drop pipe 60 ft. capacity 700 g.p.m.
Type:
___ Submersible ✓ Turbine
___ Jet ___ Reciprocating
___ Centrifugal ___ Other

5. Type and color of material

From	To
0	3
3	8
8	33
33	51
51	60
60	85½
85½	90

Sandy Top Soil
Sandy Gray Clay
Sandy Brown Clay
Fine Sand
Sand & Gravel loose Clean Med
Sand & Gravel clean Coarse loose
Brown & light Gray Clay

(Use a second sheet if needed)

18. Elevation:

Topography:
___ Hill
___ Slope
✓ Upland
___ Valley

19. Remarks:

20. Water well contractor's certification:
This well was drilled under my jurisdiction and this report is true to the best of my knowledge and belief.
Business name Rosencrantz-Bemis License No. 134
Address Great Bend, Ks.
Signed Freda Dodson Date 9/27/76
Authorized representative

22 T 14 R E W 27 Sec C NE 1/4 1/4 1/4

Forward the white, blue and pink copies to the Department of Health and Environment

Form WWC-5

MI-1023