USE TYPEWRITER OR BALL POINT PEN-PRESS FIRMLY, PRINT CLEARLY.

T R EW sec 1/4 1/4 1/4 No.

WATER WELL RECORD
KSA 82a-1201-1215

Kansas State Dept. Of Health
(Water Well Contractors)
Forbes-Bldg. 740
Topeka, Kansas 66620

1 Location of well:	County	Township name	Fraction	Section number	Town number	Range number
	Stafford		NESE	30	22S	14W

Distance and direction from nearest town or city: 4½ S

Street address of well location if in city: Radium, KS

3 Owner of well: Charles Smith

Address: R1 St. John, Kan.

Locate with "X" in section below:

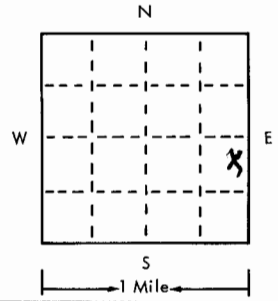

Sketch map:

4 Well depth: 62 ft. Date of completion 5-20-75
Well diameter 8 in.

5 ☐ Cable tool ☒ Rotary ☐ Driven ☐ Dug
☐ Hollow rod ☐ Jetted ☐ Bored ☐ Reverse rotary

6 Use: ☒ Domestic ☐ Public supply ☐ Industry
☐ Irrigation ☐ Air conditioning ☐ Commercial
☐ Test well ☐ _____

7 Casing: Material PVC Height: (above)/below
Threaded ☐ Welded ☐ Surface 12 in.
Diam. 5 in. to 62 ft. depth Weight _____ lbs./ft.
Drive shoe? ☐ Yes ☒ No
_____ in. to _____ ft. depth

2 Type and color of material	From	To
Top Soil - Clay	0	45
Sand - Gravel	45	62

(use a second sheet if needed)

8 Screen:
Manufacturer API
Type PVC Dia. 5"
Slot/gauze 40 Length 15'
Set between 47 ft. and 62 ft.
Fittings:
Gravel pack ☒ Yes ☐ No Size range of material 1/8 - 3/4"

9 Static water level:
16 ft. below land surface Date 5-20-75

10 Pumping level below land surfaces:
_____ ft. after _____ hrs. pumping _____ g.p.m.
_____ ft. after _____ hrs. pumping _____ g.p.m.
Estimated maximum yield 50 g.p.m.

11 Water sample submitted:
☐ Yes ☒ No Date _____

12 Well head completion:
☐ Pitless adapter ☒ 12 Inches above grade

13 Well grouted? ☒ Yes ☐ No
☒ Neat cement ☐ Bentonite ☐ _____
Depth: From _____ ft. to _____ ft.

14 Nearest source of possible contamination:
ft. 60 Direction E Type Barn yard
Well disinfected upon completion? ☒ Yes ☐ No

15 Pump: ☒ Not installed
Manufacturer's name _____
Model number _____ HP _____ Volts _____
Length of drop pipe _____ ft. capacity _____ g.m.p.
Type:
☐ Submersible ☐ Turbine
☐ Jet ☐ Reciprocating
☐ Certrifugal ☐ Other

16 Remarks: elevation

Topography:
☐ Hill
☐ Slope
☒ Upland
☐ Valley

17 Water well contractor's certification:
This well was drilled under my jurisdiction and this report is true to the best of my knowledge and belief.
Business name Kelly's Waterwell Ser License No. 184
Address R 2 Great Bend KS
Signed Kelly Price Date 5-30-75
Authorized representative

Forward the white, blue and pink copies to the Kansas State Dept. Of Health.

Form WWC-5

677-H